


G-6348


52681

T. 1S., R. 32E., W.M.

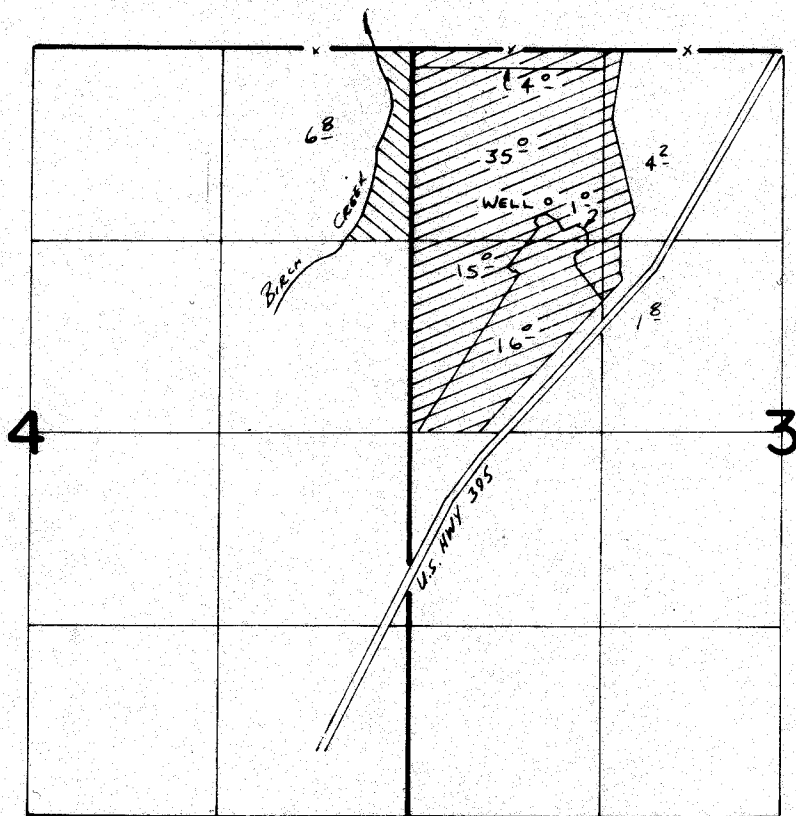

WELL LOCATED 1020'S. & 940'E. FROM NW COR. SEC. 3

**FINAL PROOF SURVEY**  
UNDER

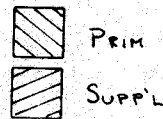

Application No. **G:6619**. Permit No. **G:6348**.  
IN NAME OF

**WILBUR M. HEMPHILL**

Surveyed **OCT. 4**, 19**77**, by **R. BARWIN**