


T. 1S., R. 32E., W. M.

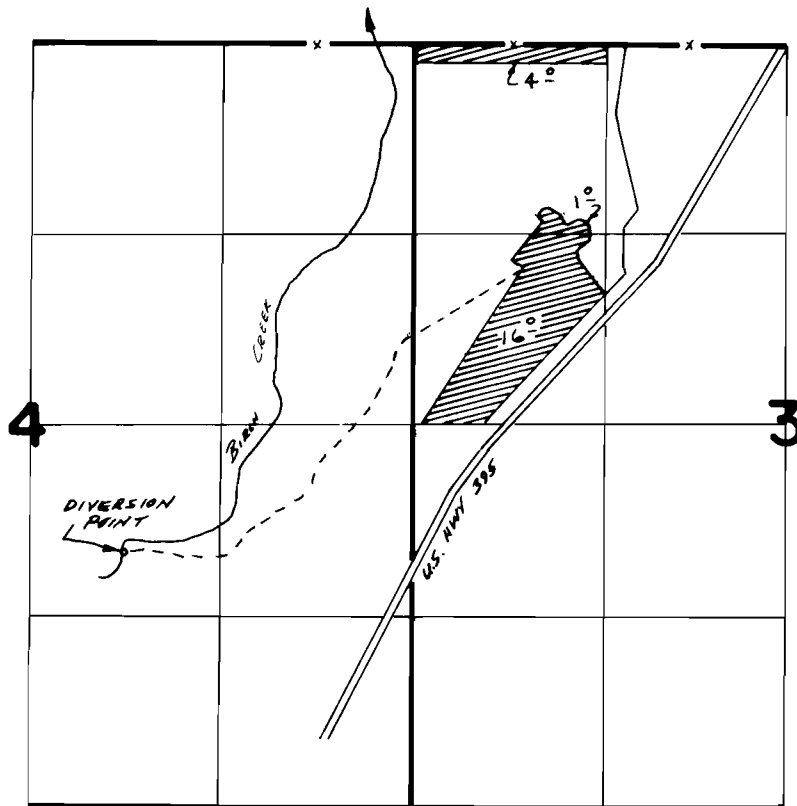

CREEK DIVERSION POINT LOCATED 3490'S. & 1980'W. FROM NW COR. SEC. 3

**FINAL PROOF SURVEY**  
UNDER

Application No. **52281**... Permit No. **39341**...  
IN NAME OF

.....**WILBUR M. HEMPHILL**.....

Surveyed ...**OCT. 4**... 19**77**... by ...**P. BARWIN**.....