


T.5S.,R.4W.,W.M.

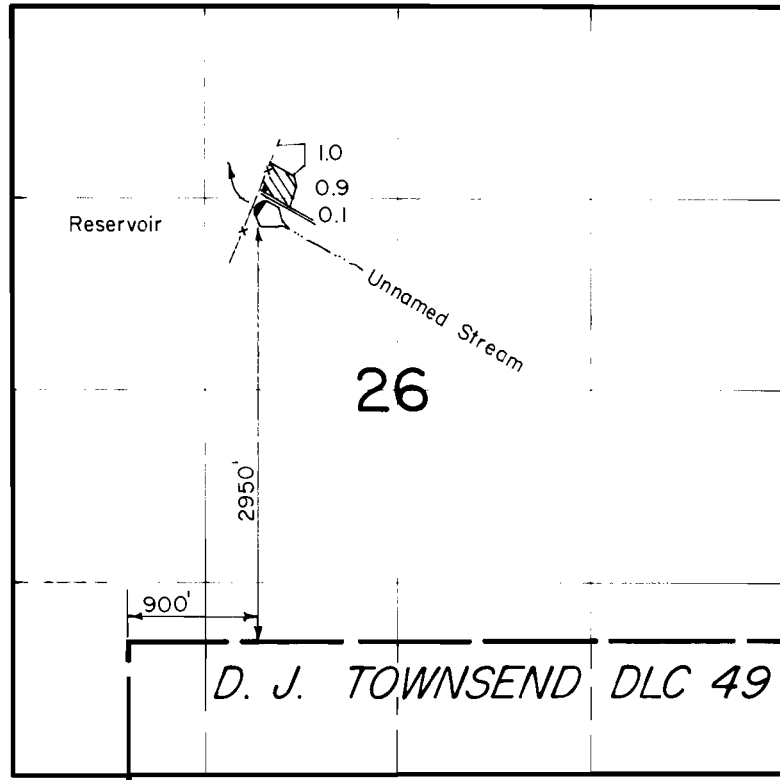

FINAL PROOF SURVEY
UNDER

R-51684 R-6060
Application No. 51685 Permit No. 37334

IN NAME OF

F. M. ZEITOUN

Surveyed MAY 29, 1980, by *M. Brown*