


T. 8 S. R. 39 E. W.M.

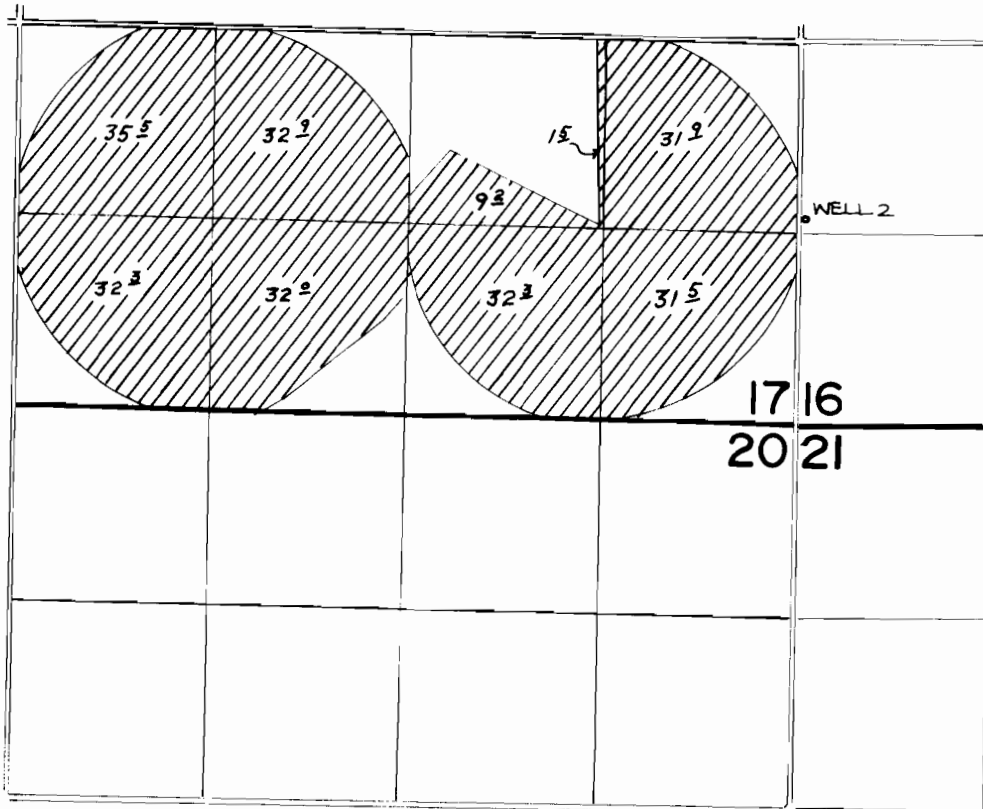

WELL 2 LOC: 1210 FT. S. AND 50 FT. E. FROM W. 1/4 COR. SEC. 16

FINAL PROOF SURVEY UNDER

Application No. **G-7012** Permit No. **G-6512**.....
IN NAME OF

.....**JAMES BLATCHFORD**.....

Surveyed ~~MARCH 28~~..... 1983, by **V.L. GRUEN**.....