


RECEIVED
MAY 13 1984
WATER RESOURCES DEPT


T. 7S., R. 48E., W.M.

NW1/4 NW1/4

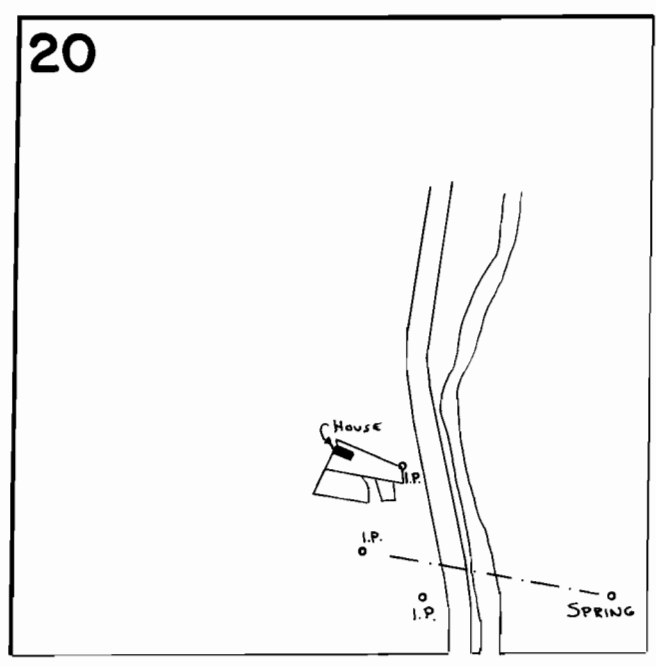

SPRING Loc: 1200'S. & 1240'E. FROM NW. COR. SEC. 20

FINAL PROOF SURVEY
UNDER

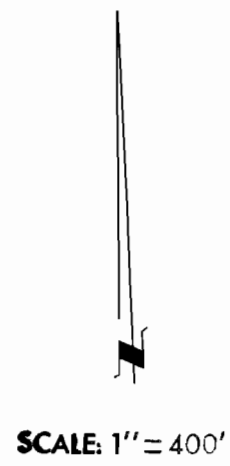

Application No. ~~61199~~ Permit No. ~~45525~~
IN NAME OF
Hells Canyon Adventures Inc.

Surveyed *May 23* 19*84*, by *V.L. Church*