


T. 5 S. R. 1 W. W. M.

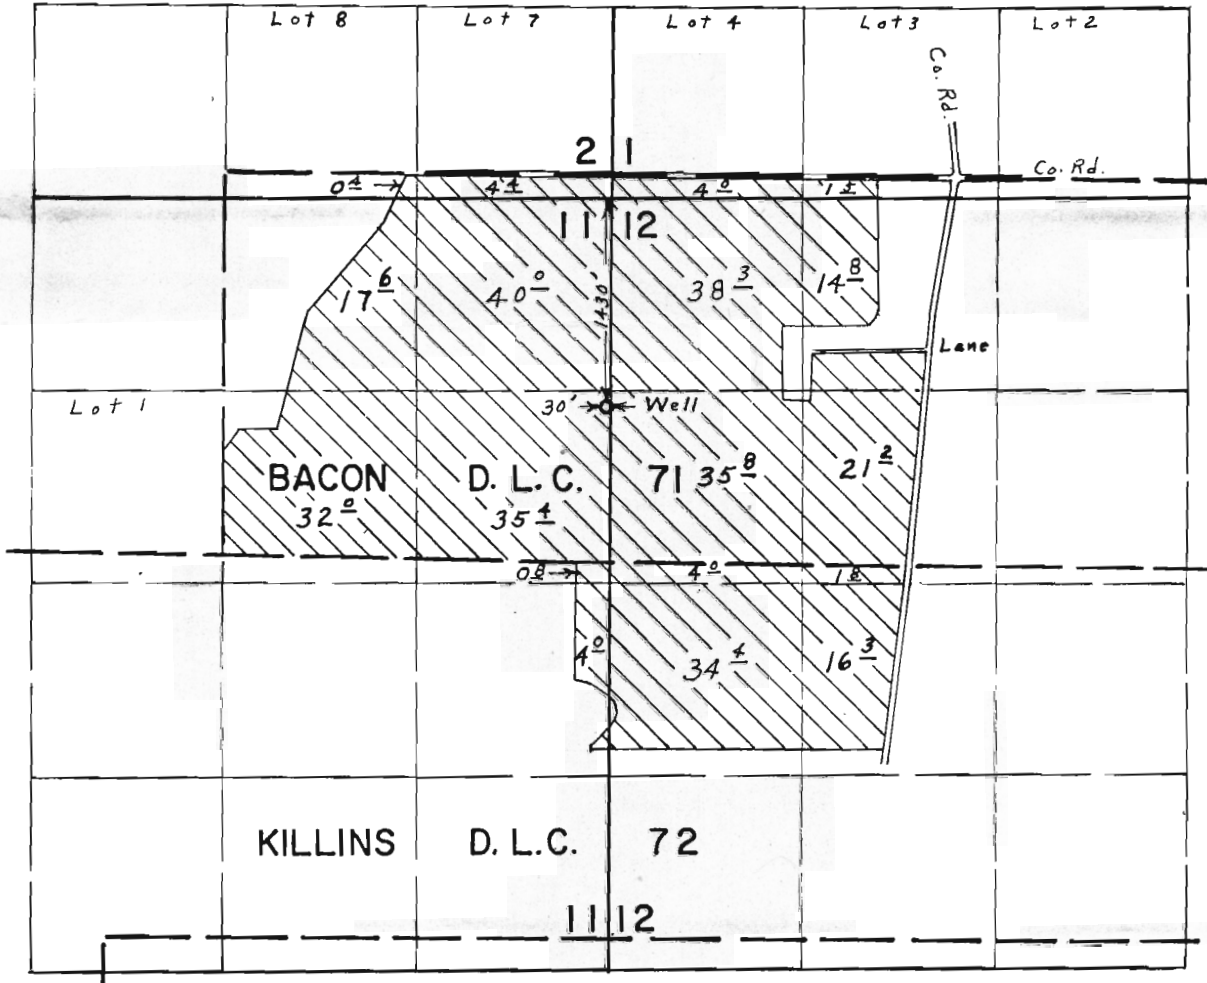

Application No. **G 7765**
 Permit No. **G 8554**

FINAL PROOF SURVEY UNDER

Application No. ~~G 5224~~ Permit No. ~~G 5083~~
 IN NAME OF

~~J. H. S.~~ RAYMOND SCHWABAUER

Surveyed March, 31, 1976, by L. E. Gould

RECEIVED

MAY 08 1979

**WATER RESOURCES DEPT.
 SALEM, OREGON**