


T.26S., R.6W., W.M.

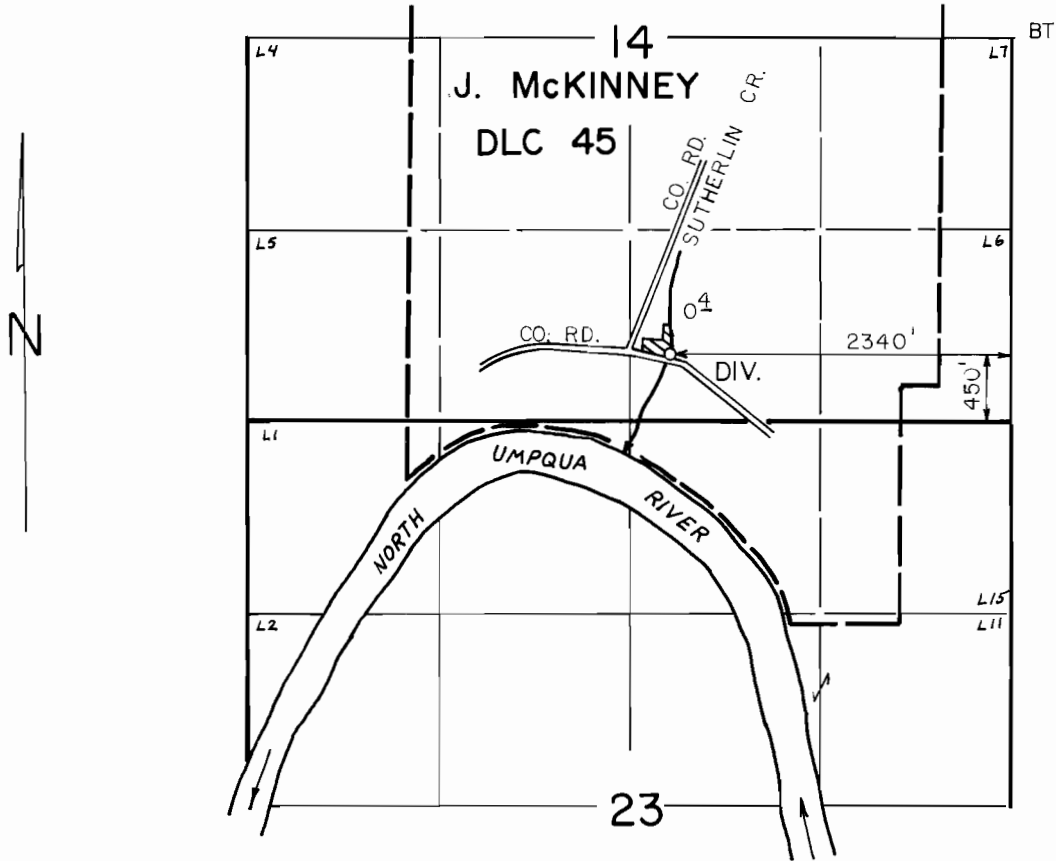

SCALE: 4" = 1 mile

**FINAL PROOF SURVEY**  
UNDER

Application No. 55094 Permit No. 41327.....  
IN NAME OF

**HERMAN H. & FAYNA L. BRAUNER**

Surveyed NOV. 8, 1983, by *J.E. Cashion*.....  
*Aug 30, 1976 by D. Norby*