


T.26S.,R.4W.,W.M.

Section 34

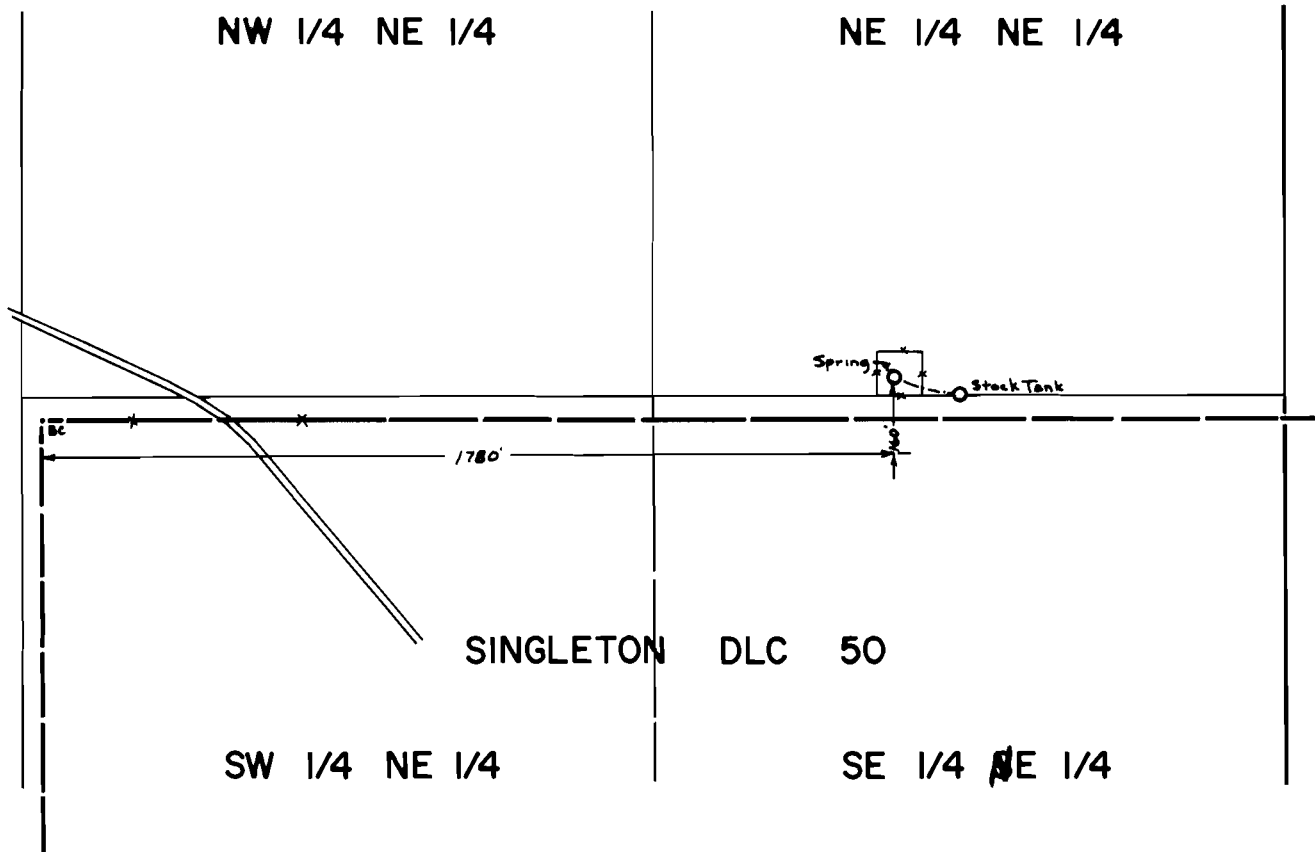

SCALE: 1" = 400'

FINAL PROOF SURVEY
UNDER

Application No. ...56370. Permit No. ...42387....
IN NAME OF

.....MARRIN SIGFRIDSON.....

Surveyed May 20 1980, by J.S. DONALDSON
May 10 1982 by L.M. TOLL