


RECEIVED

FEB 13 1979

WATER RESOURCES DEPT.
SALEM, OREGON

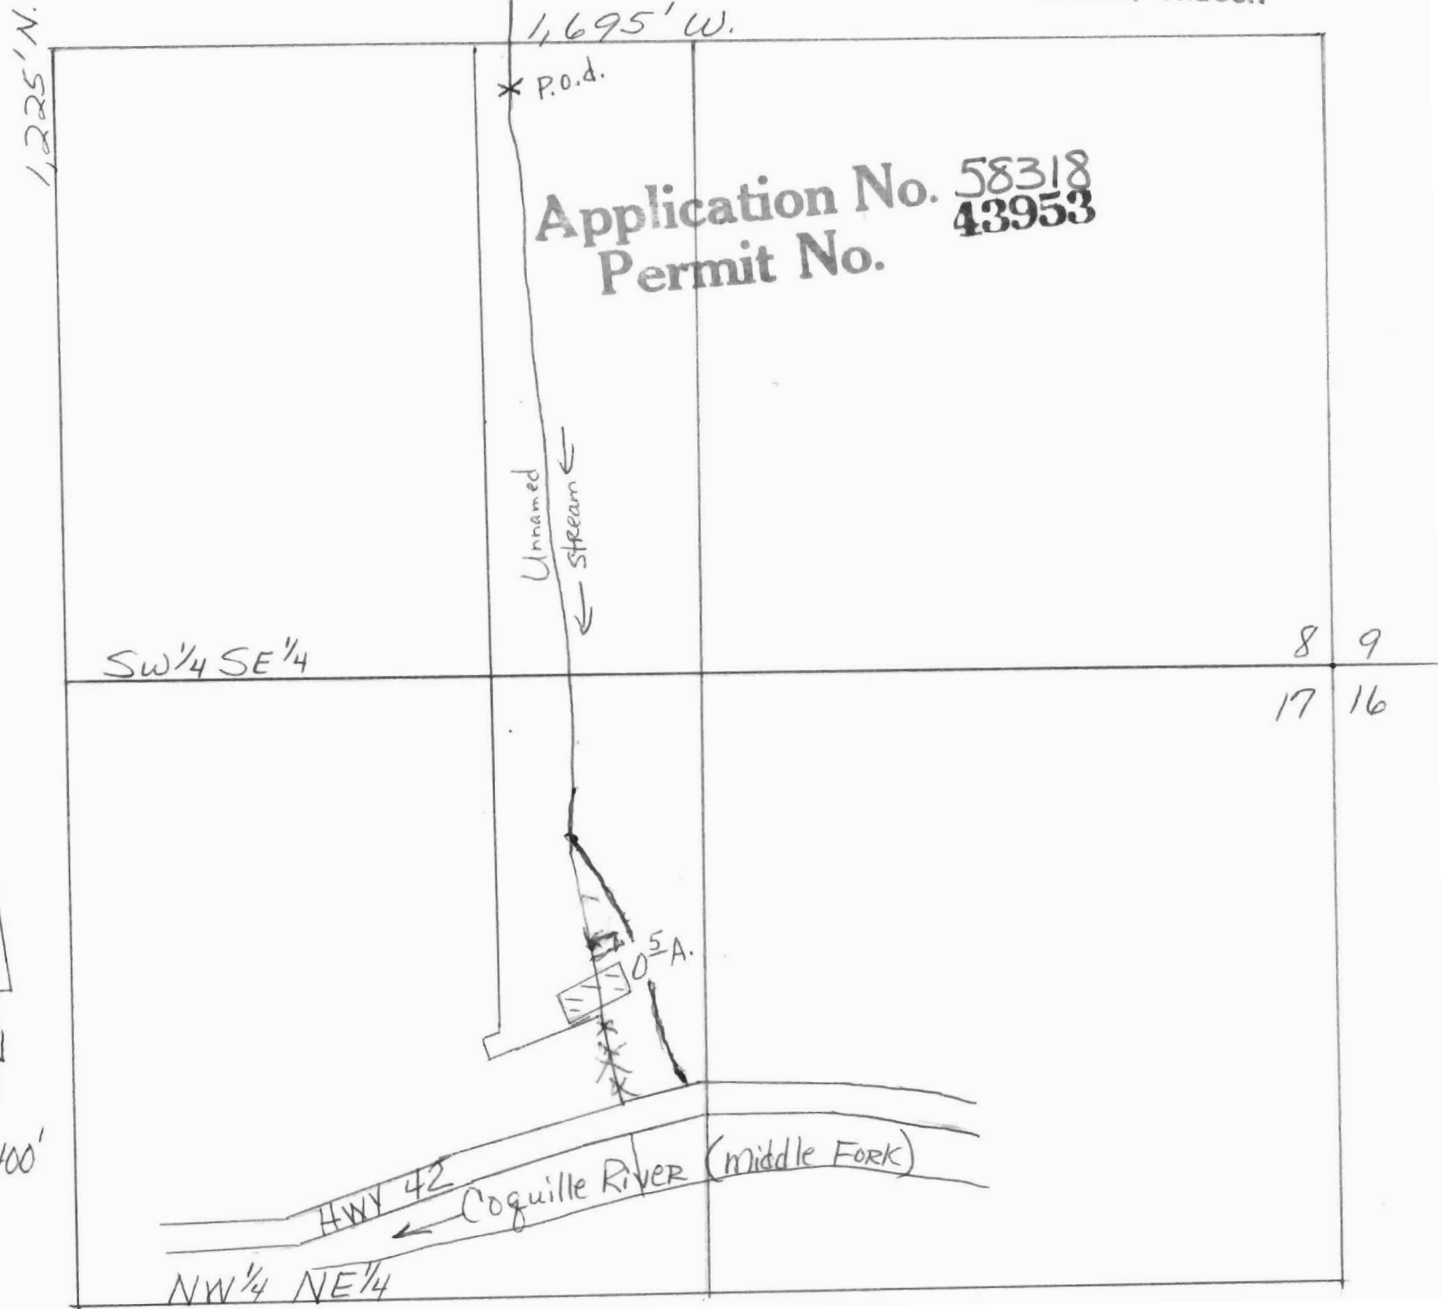

T. 30 S., R. 9 W., Sec. 8
17