


T.28S., R.6W., W.M.

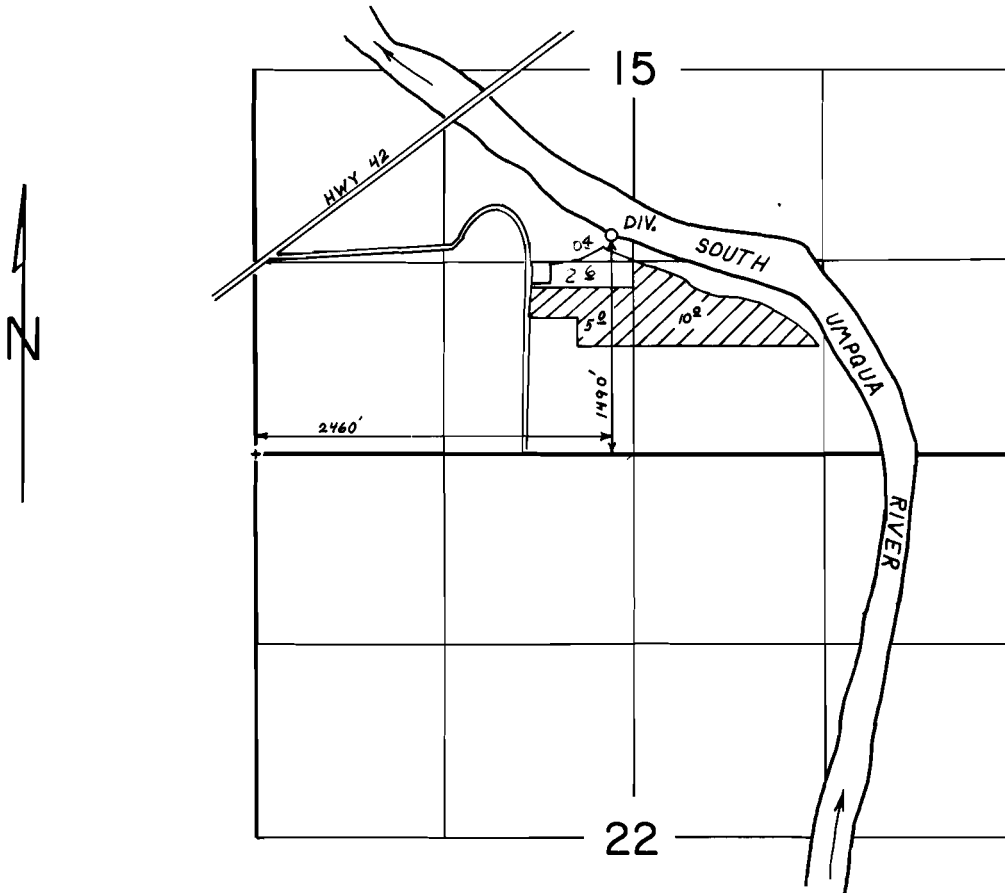

SCALE: 4" = 1 mile

FINAL PROOF SURVEY
UNDER

Application No. 63072... Permit No. 46654.....
IN NAME OF

DONALD C. TOYE

Surveyed DEC. 9, 1983, by *J.E. Cashion*.....