


T. 26 S., R. 3 W., W.M.

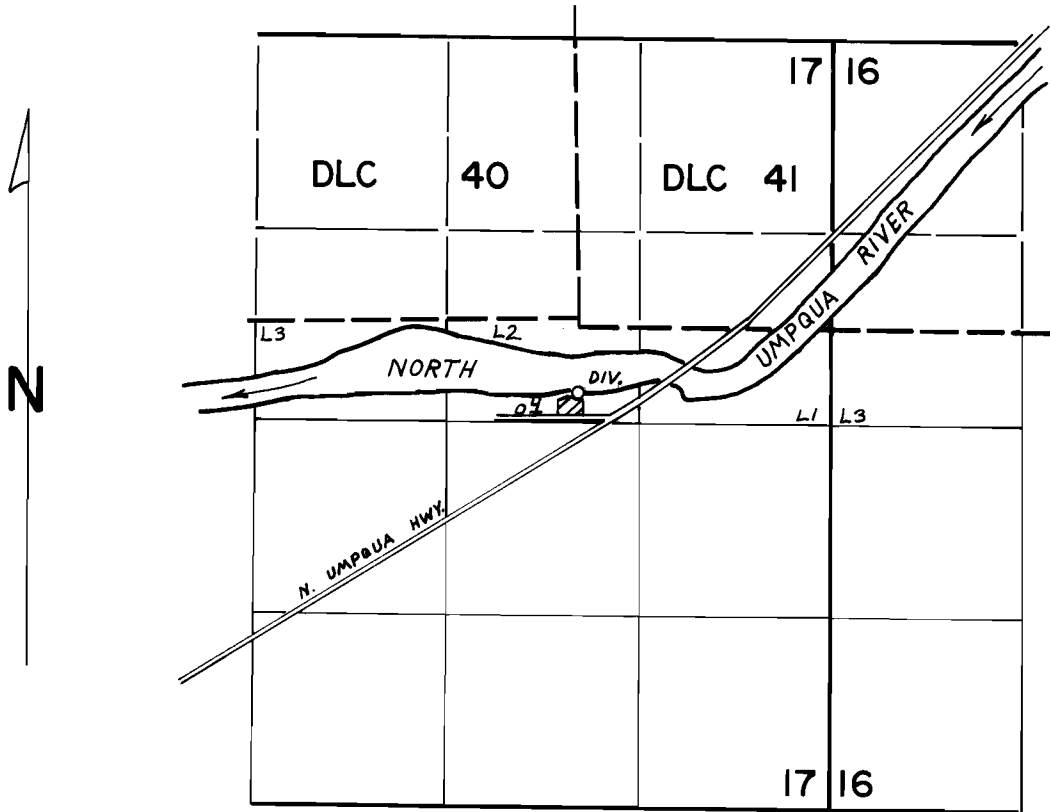

DIV. PT. LOCATED 440' S. AND 10' W. FROM THE SW. CORNER DLC 41.

SCALE: 4" = 1 mile

FINAL PROOF SURVEY
UNDER

Application No. 68107.... Permit No. 48552.....
IN NAME OF

RUTH E. MILLER

Surveyed OCT. 17, 1984, by *L.E. Carlson*