


T.13 S. R.31 E. W.M.

Application No. 58529
Permit No. 44104

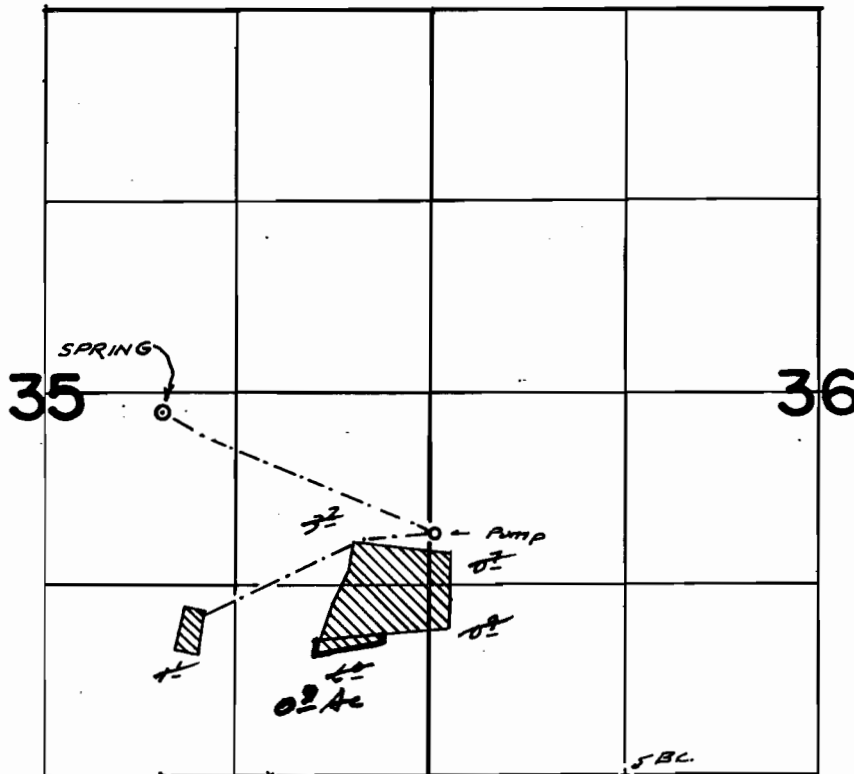

SPRING LOC: 2500' N. & 3150' W. FROM S.E. COR. SW 1/4 SW 1/4 SEC. 36

RECEIVED

APR 13 1979

~~FINAL PROOF SURVEY~~ WATER RESOURCES DEPT.
UNDER SALEM, OREGON

~~Application No. 49615 Permit No. 36706~~
IN NAME OF

Mid County Cemetery Maintenance District

~~Surveyed Sept. 20 1977, by S.G. BROWN~~