


T. 39 S., R. 7 W., W.M.

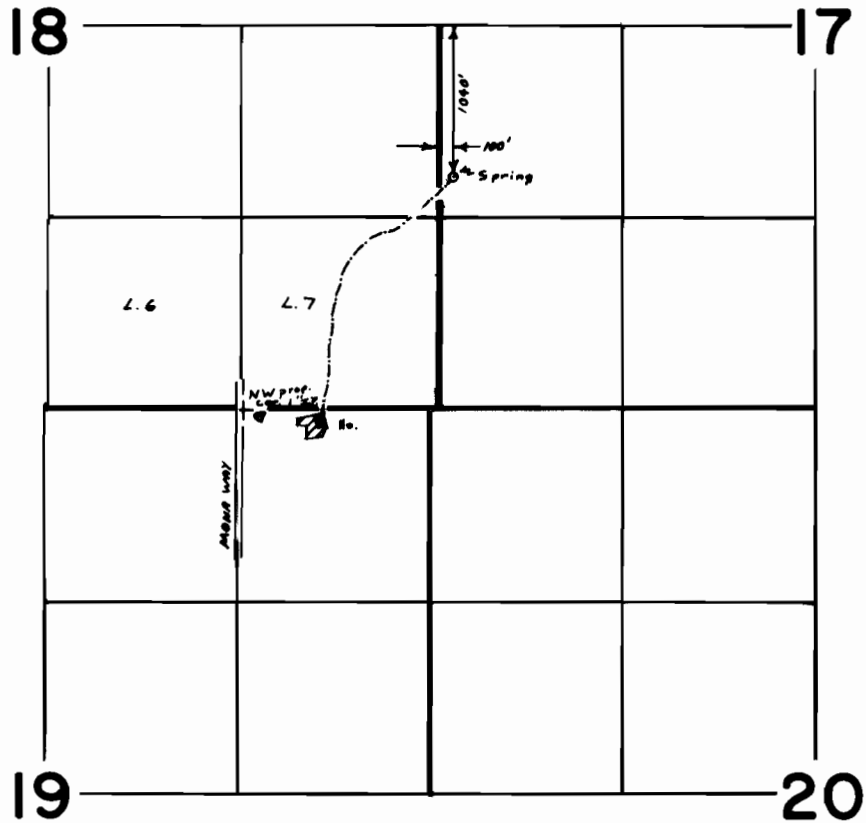

FINAL PROOF SURVEY
UNDER

Application No. **54664** Permit No. **41013**.....
IN NAME OF

.....**CAROLYN M. DEATON**.....

Surveyed **April 30, 1980**, by **B. R. SUND**.....