


T. 19 S., R 12 W. WM.

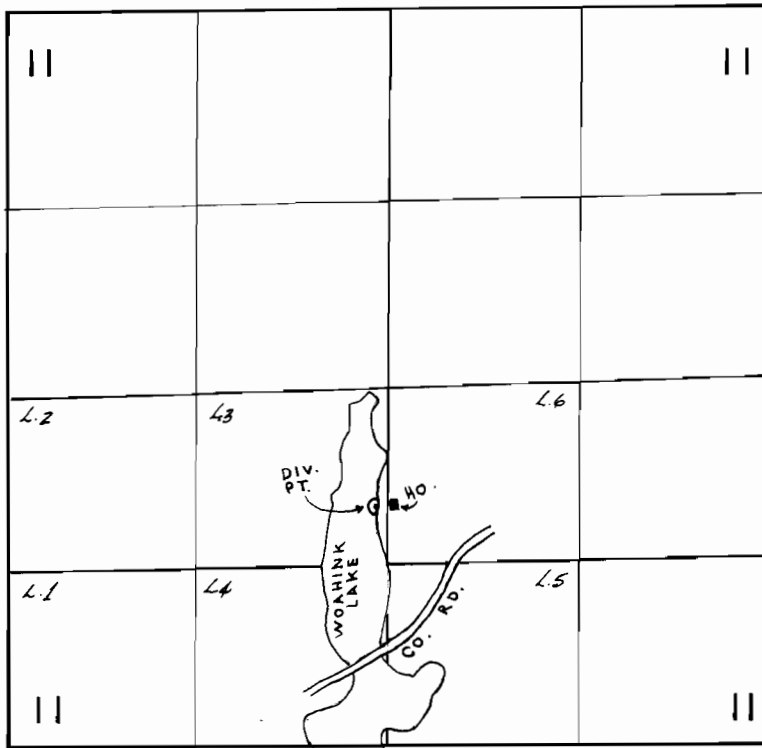

DIV. PT. LOC. 1635' N. & 2550' E. OF SW COR. SEC. 11

FINAL PROOF SURVEY
UNDER

Application No. 65143 Permit No. 47582
IN NAME OF

IRWIN LEACH

Surveyed JUL 16 1984 by P. PAGTER