


T.17S. R.47E. W.M.

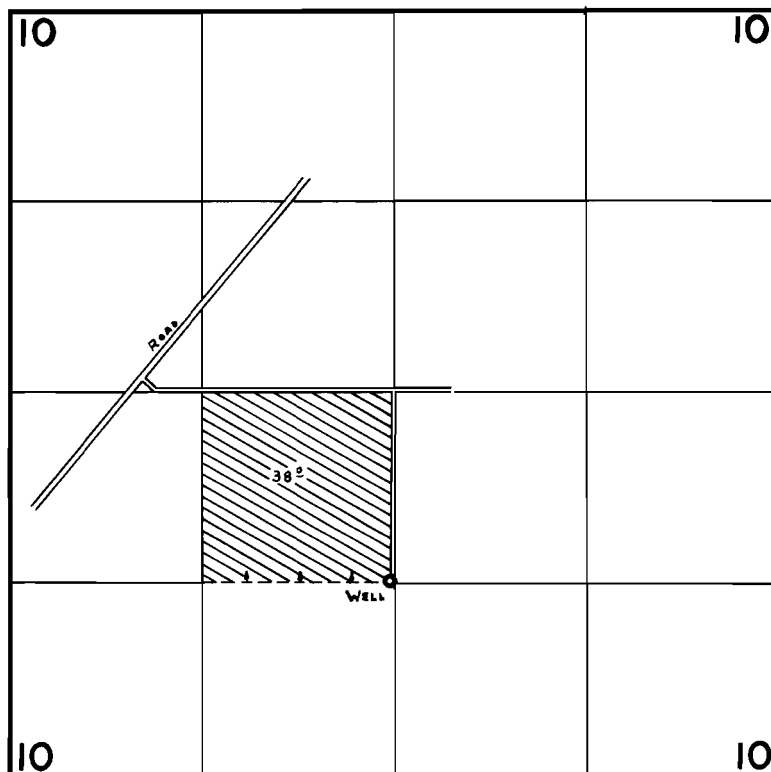

WELL Loc: 10' N. & 35' W. fr. S.E. Cor. of NE $\frac{1}{4}$ SW $\frac{1}{4}$ SEC. 10.

FINAL PROOF SURVEY
UNDER

Application No. G-6716... Permit No. G-6255...
IN NAME OF

GRACE CURFMAN

Surveyed Aug. 4, 1979, by C. L. HUGHES