


T.7S.,R.2W.,W.M.

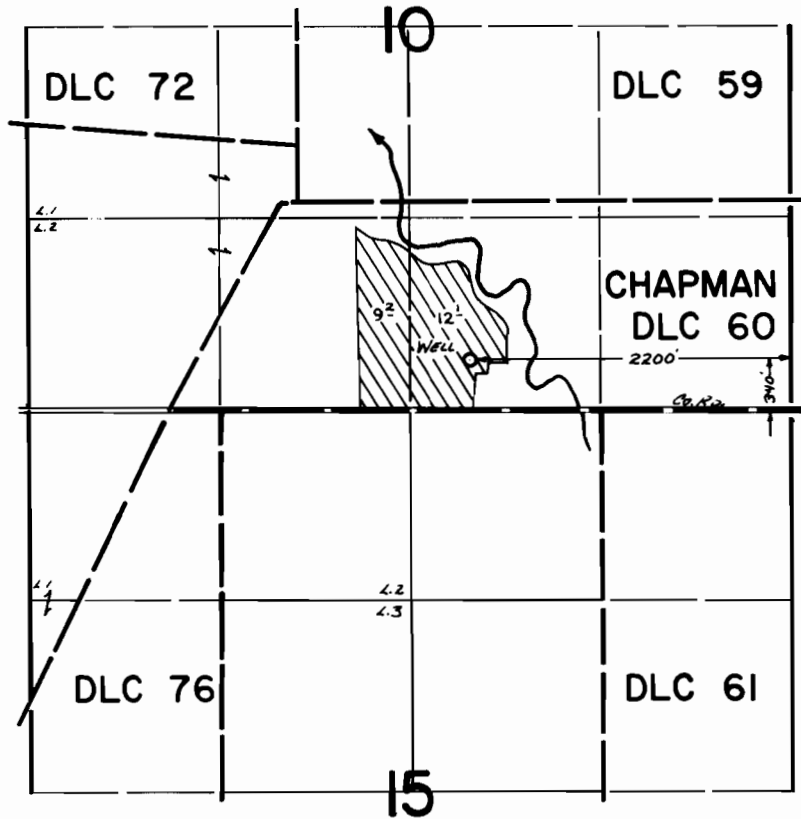

FINAL PROOF SURVEY UNDER

Application No. G-7739 Permit No. G-7192.....
IN NAME OF

.....**LYLE G. HADLEY**.....

Surveyed Oct. 30, 1981, by S. G. BROWN.....