T. 5N., R. 26E., W. M.

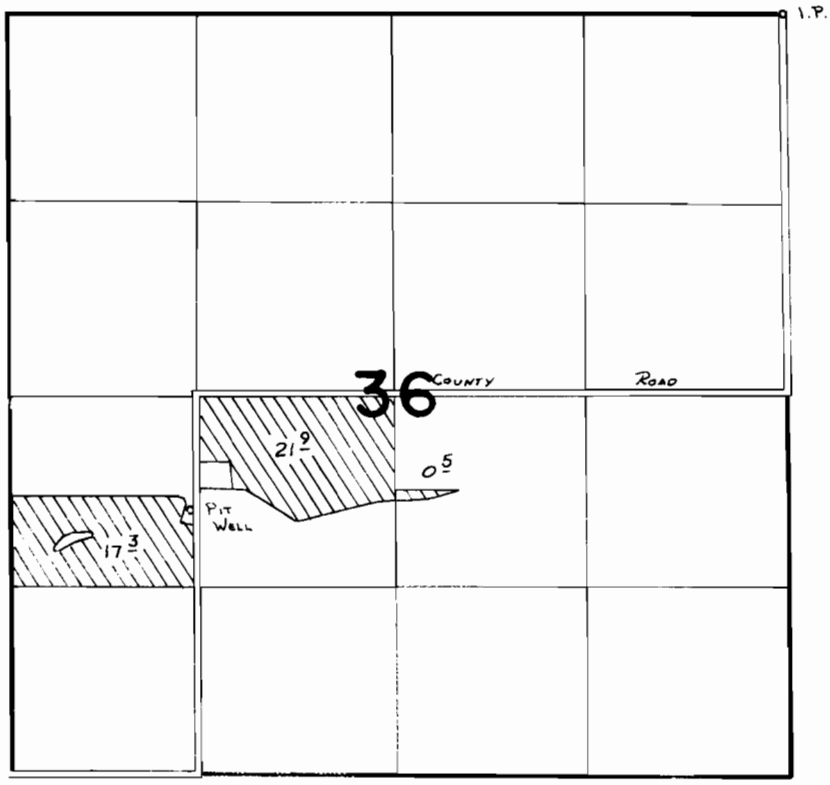

PIT WELL LOC: 770' S. & 1400' W. FROM CENTER COR. SEC. 36

SCALE: 1" = 1320'

FINAL PROOF SURVEY
UNDER

Application No. G-5894 Permit No. G-5039
IN NAME OF

MRS. BARBARA VOLLE

Surveyed 4-7 19 78, by R. BARWICK

272-237

Rev. 9-25-84
V.L.C.