


T. 2S. T. 38E. W.M.

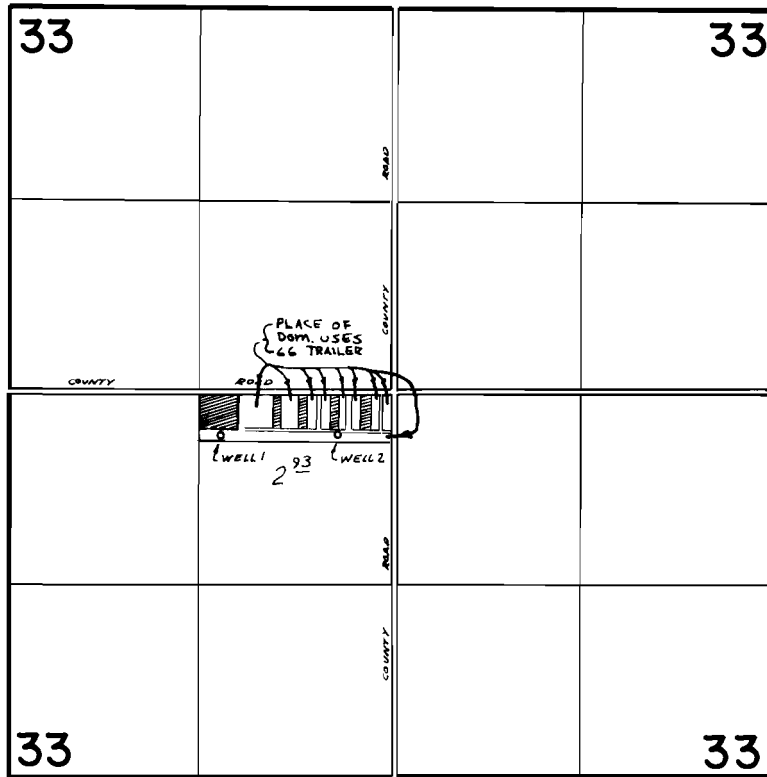

WELL 1 LOC. 300'S & 1200'W. FROM CENTER OF SEC 33
WELL 2 LOC. 300'S & 400'W. FROM CENTER OF SEC 33



SCALE: 1" = 1320'

FINAL PROOF SURVEY
UNDER

Application No. G-7122 Permit No. G-6694
IN NAME OF

FLYING K TRAILER RANCH

Surveyed 10-11 1977, by R. BARWIN