


T. 1S. R. 38E. W.M.

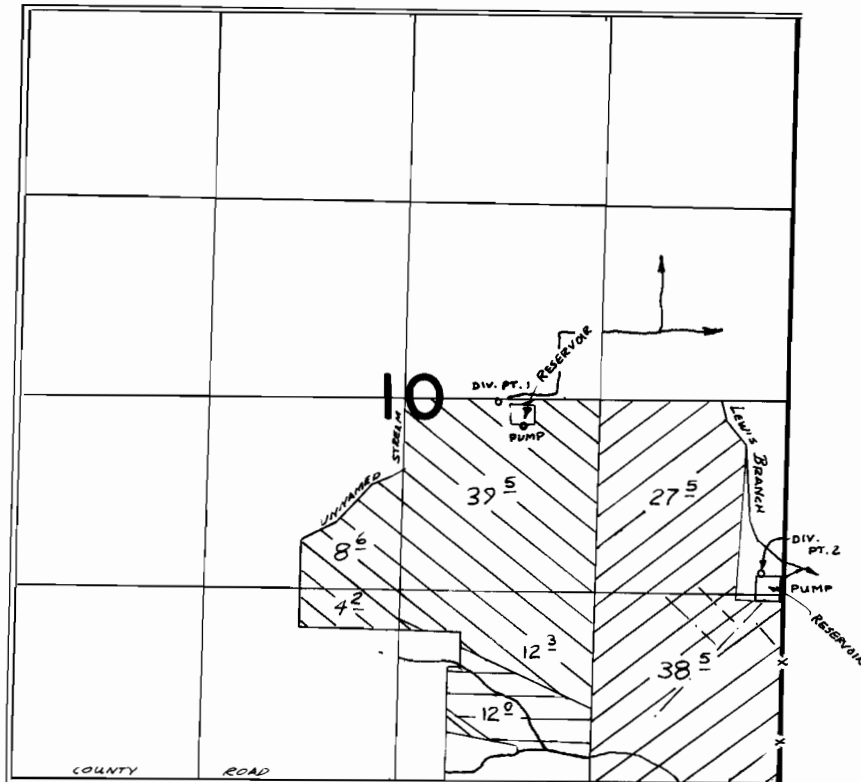

DIVERSION POINT 1 LOCATED 10'S. & 640'E. FROM CENTER SEC 10
 DIVERSION POINT 2 LOCATED 1470'N. & 150'W. FROM SE COR SEC 10

PER. 37902



PER 42334



PRIM



SUPP'L

FINAL PROOF SURVEY

UNDER

50972
 R-50971
 50234

42334
 R-6703
 37902

Application No. R-50233 Permit No. R-6131
 IN NAME OF

ALFRED A. ARNOLDUS

Surveyed 6-12 1978, by R. BARWIN