


T. 1S. R. 38E. W.M.

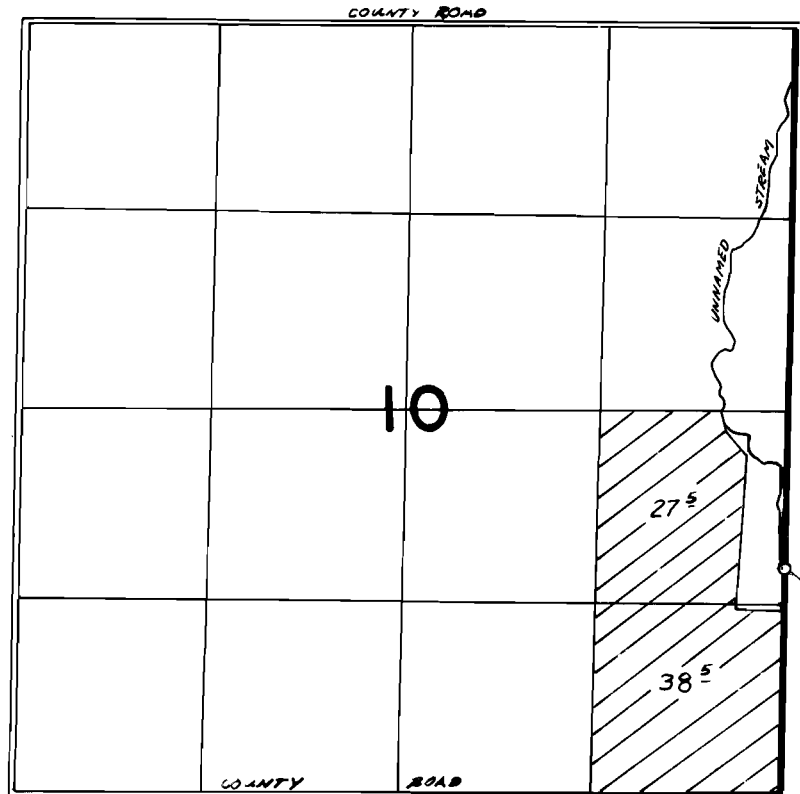

DIVERSION POINT LOCATED 1550'N FROM SE CORNER SECTION 10

FINAL PROOF SURVEY
UNDER

Application No. **56088** Permit No. **42335**
IN NAME OF

ALFRED A. ARNOLDUS

Surveyed **8-28** 19**79**, by *V. Church & P. J. Smith*