
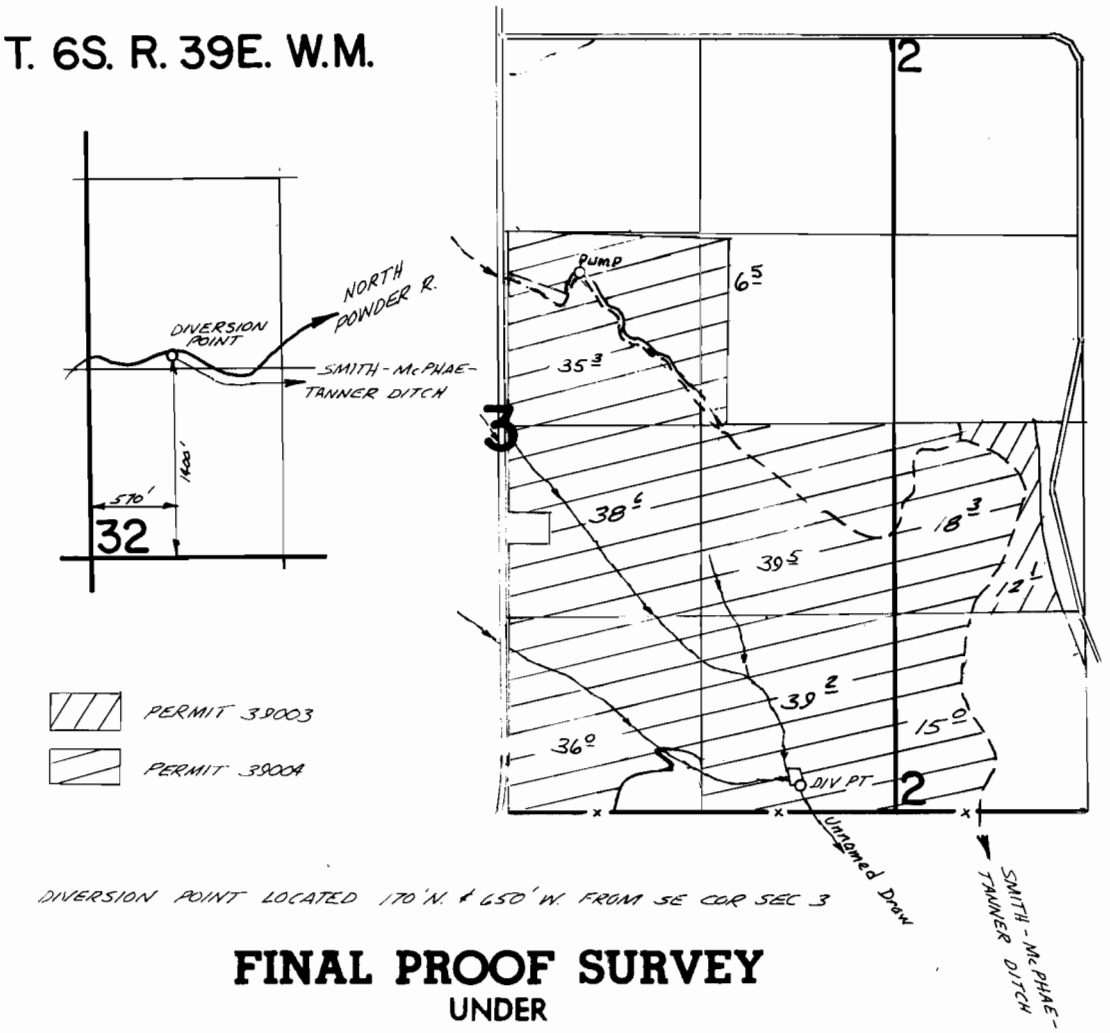

DIVERSION POINT LOCATED 170' N. & 650' W. FROM SE COR SEC 3

FINAL PROOF SURVEY
UNDER

Application No. 51757 / 51758 Permit No. 39003 / 39004
IN NAME OF

GARY L. KRAMER

Surveyed OCT. 27 19 77, by R. BARWIN

BBB - 4KK - 256
BBB - 2N - 202
PTS - 1977-5-B