


T. 11S. R. 43E. W. M.

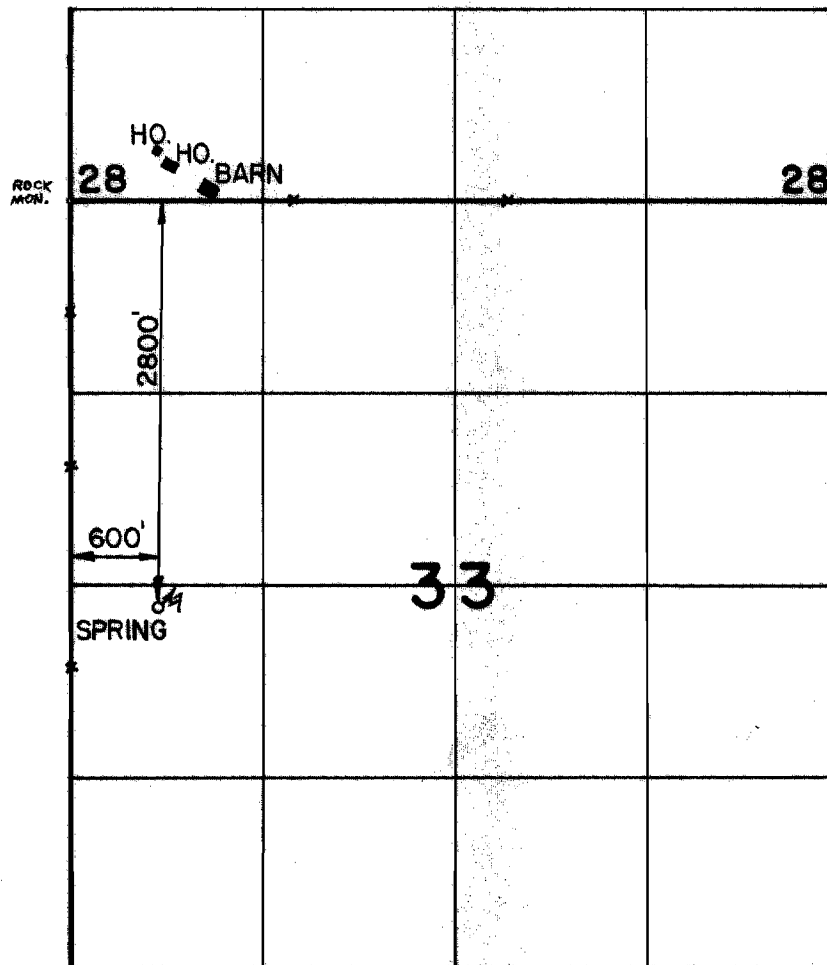

**FINAL PROOF SURVEY**  
UNDER

Application No. 56466 Permit No. 42036  
IN NAME OF

**TED S. & DOROTHY E. BLOOMER**

Surveyed 11-1-1978, by R. BARWIN