


# T.11S., R.6W., W.M.

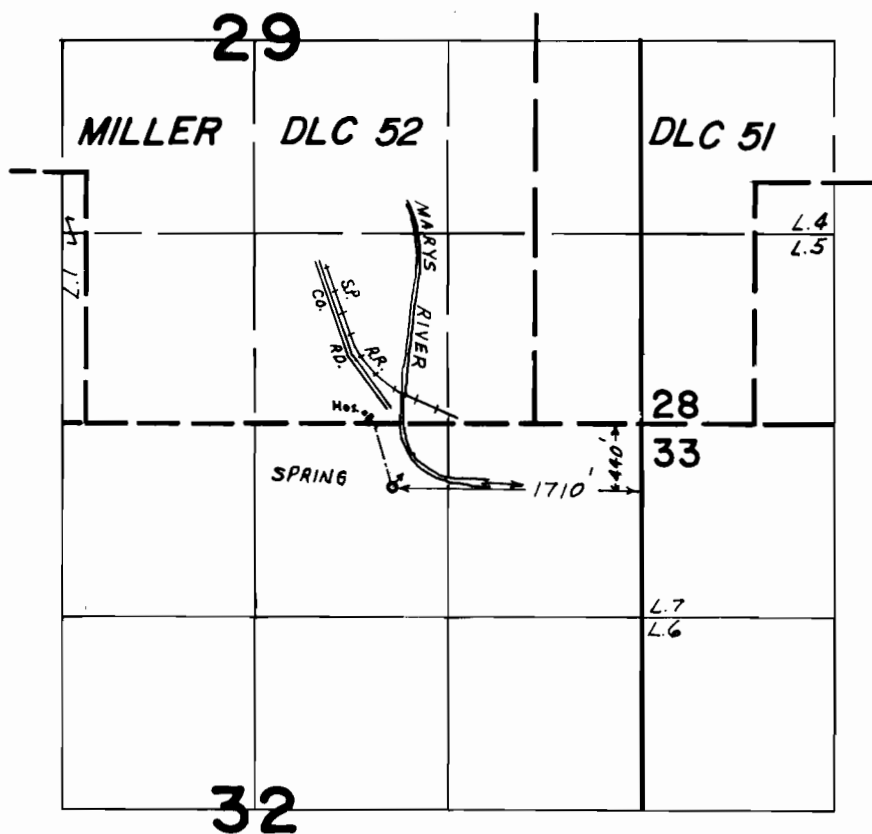

## FINAL PROOF SURVEY UNDER

Application No. 49554 Permit No. 37091  
IN NAME OF

HARRIET SHUFORD

Surveyed SEPT. 26 1978, by J.S. DONALDSON