


T.3S.,R.1E.,W.M.

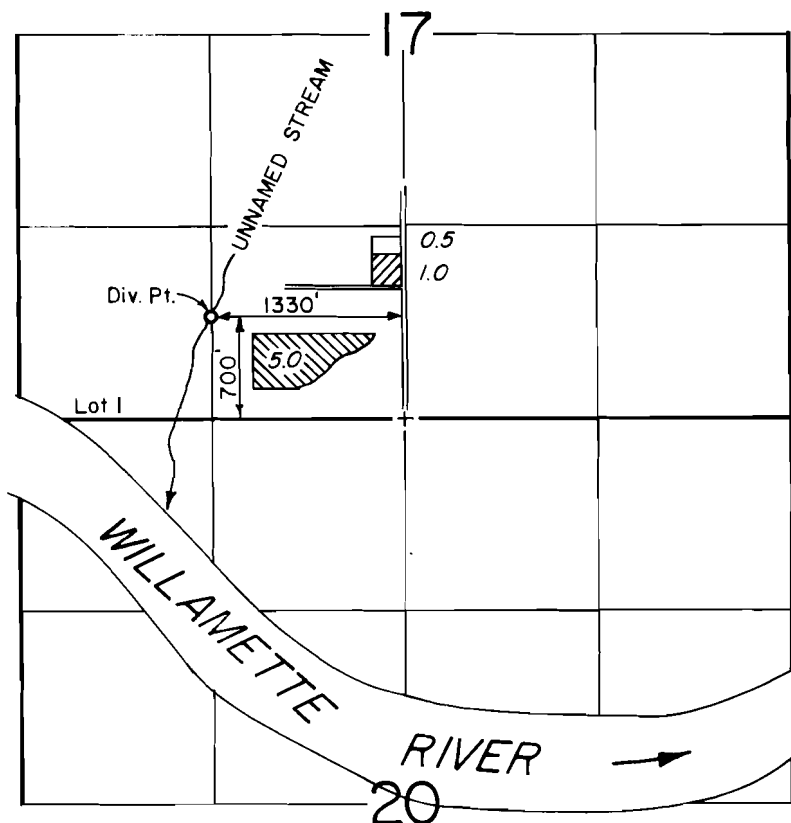

FINAL PROOF SURVEY
UNDER

Application No. 57266 43085
59934 Permit No. 45021

IN NAME OF

EARL BRUCK

Surveyed JAN. 18, 1980, by R. G. MUCKEN
AUG. 3, 1981, S. BROWN