


T.22S.,R.12W.,W.M.  
SEC. 31

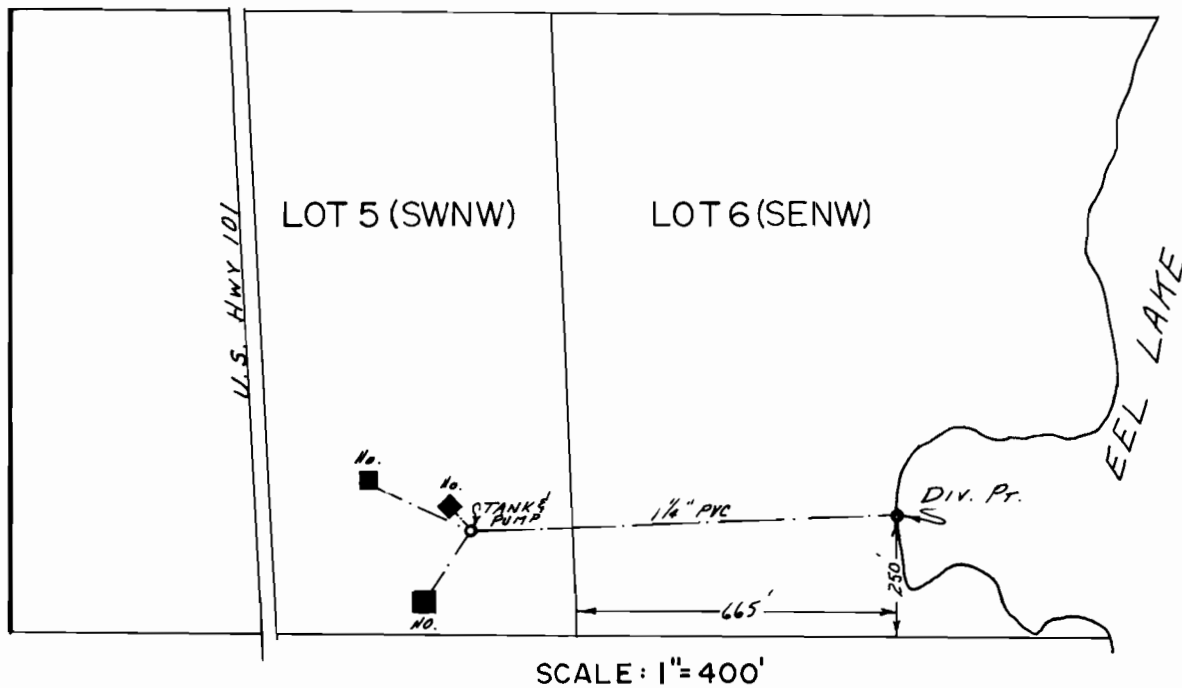

**FINAL PROOF SURVEY**  
UNDER

Application No. 48354.. Permit No. 35608.....  
IN NAME OF

JIM BASTOW

Surveyed JUNE 3, 1980, by J.S. DONALDSON