


T. 35 S., R. 2 E., W.M.

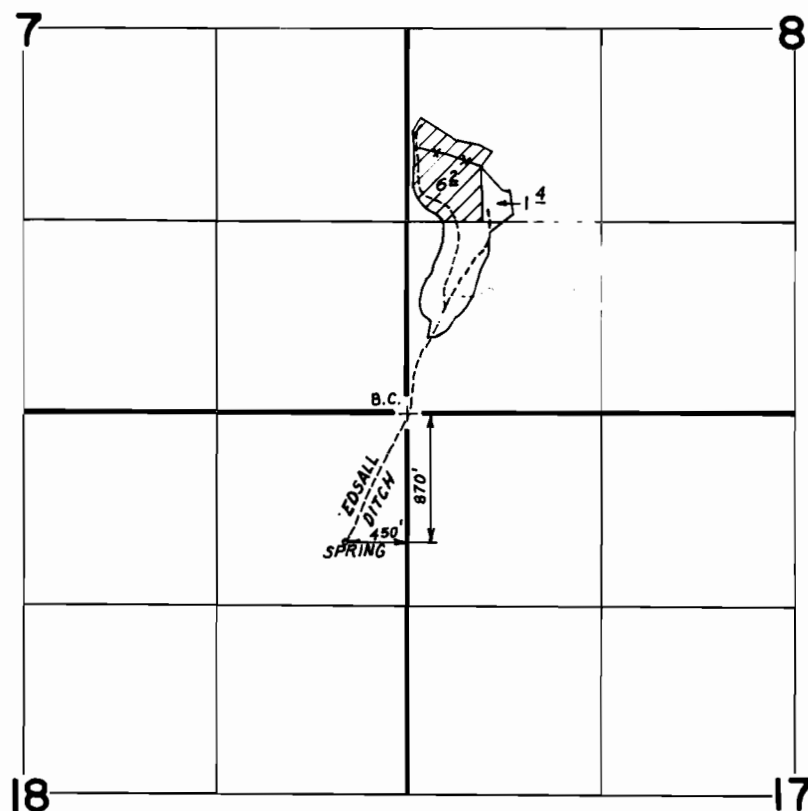

Scale: 4" = 1 Mile

FINAL PROOF SURVEY
UNDER

TRANSFER NO. 3314

Application No. Permit No.
IN NAME OF

..... CURTIS THOMSON

Surveyed JULY 15, 1982, by BRUCE R. SUND