



T. 34S., R. 5 W., W.M.

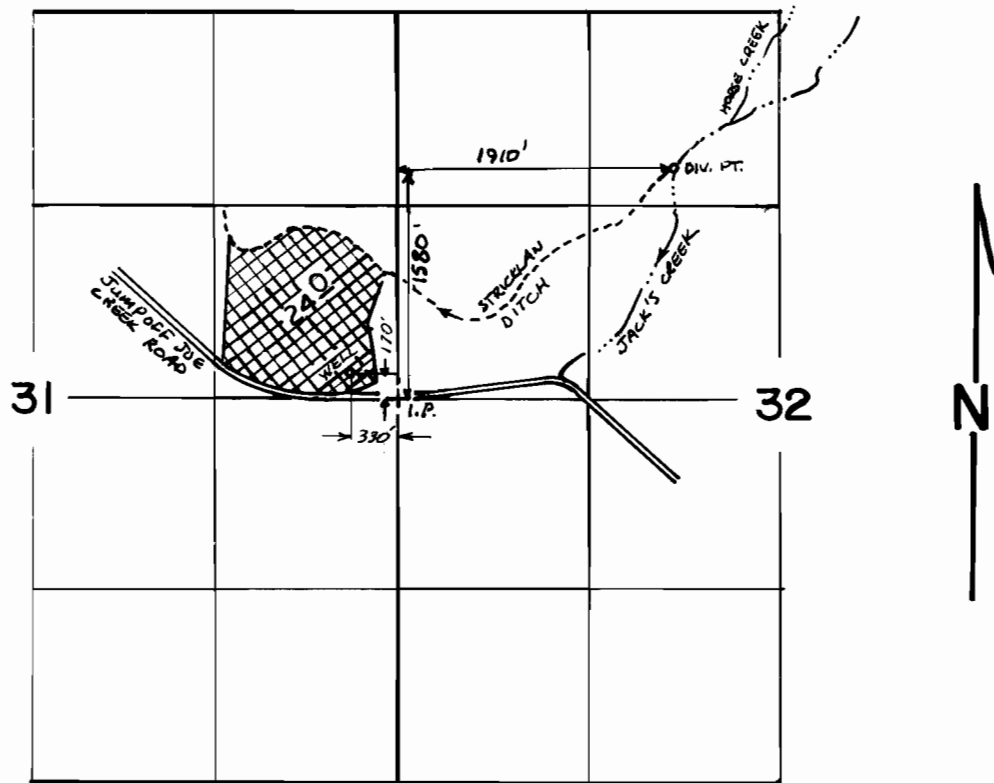

SCALE: 4" = 1 MILE

 JACK'S CREEK

 WELL

FINAL PROOF SURVEY
UNDER

G-10580 G-9778
Application No. 65502 Permit No. 47735....
IN NAME OF

RICHARD D. STRICKLAN.....

Surveyed JULY 12, 1984 by B. S. JAMES