


T. 39 S., R. 8 W., W.M.

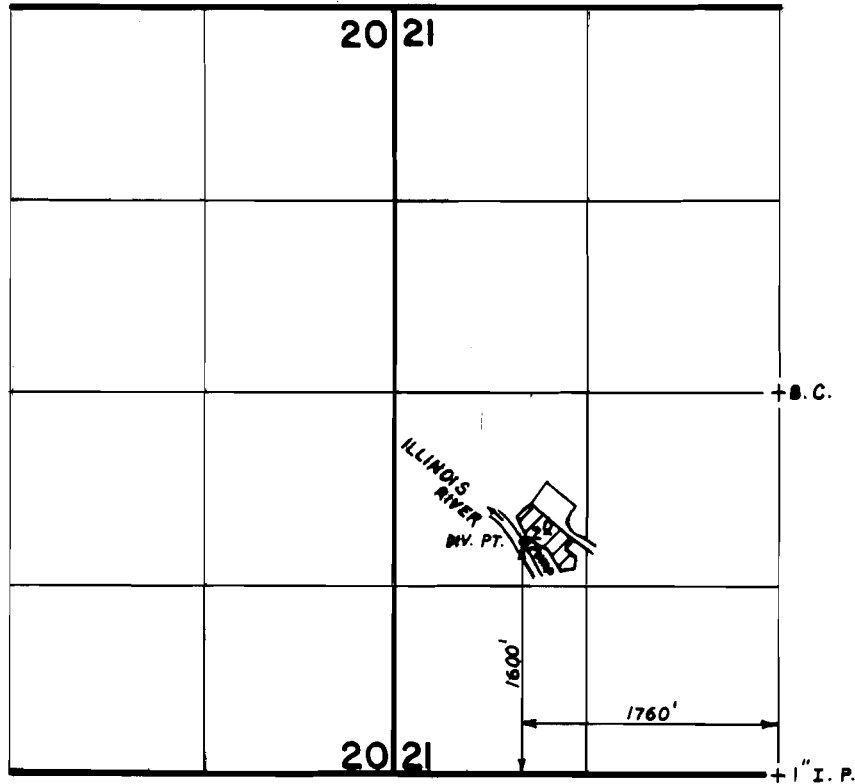

SCALE: 1" = 1320'

**FINAL PROOF SURVEY**  
UNDER

Application No. **55946** Permit No. **42224**  
IN NAME OF

**OREGON STATE PARKS & RECREATION BRANCH**

Surveyed **AUG. 3** 19 **78**, by **BRUCE R. SUND**  
**AUG. 26** 82 **BRUCE R. SUND**