


G-7474
52783

T.25S. R.18E. W.M.

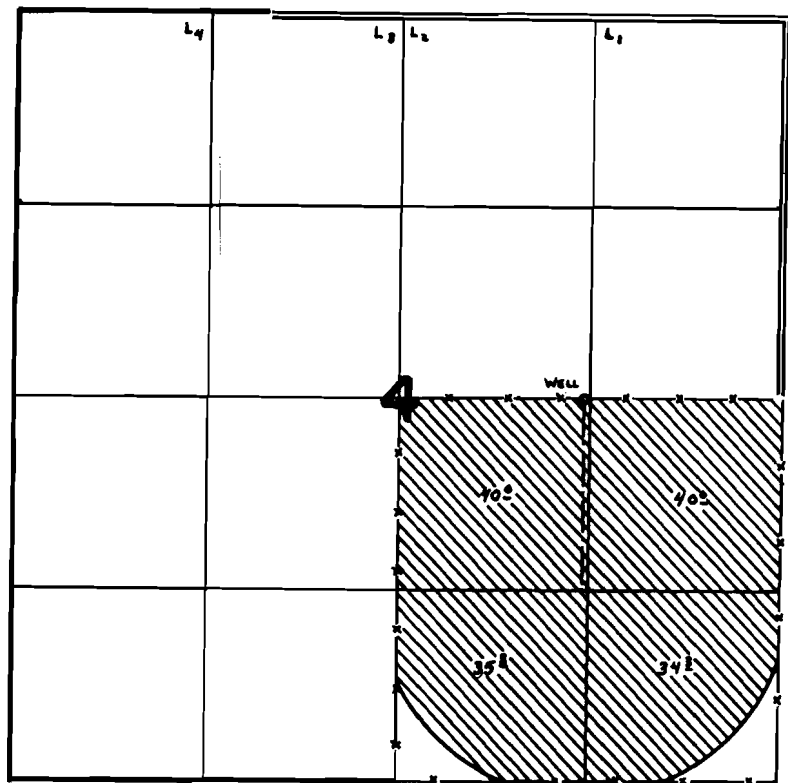

WELL LOC: 10'S. & 1200' E. fr. C. 1/4 Cor. Sec. 4.

FINAL PROOF SURVEY
UNDER

Application No. G-8079.. Permit No. ..G-7474....
IN NAME OF

JAMES BROUGHAM DINSDALE

Surveyed Aug....27. 19.79., by ..C. L. HUGHES....