


G 8199

52784

T.27S.,R.17E.,W.M.

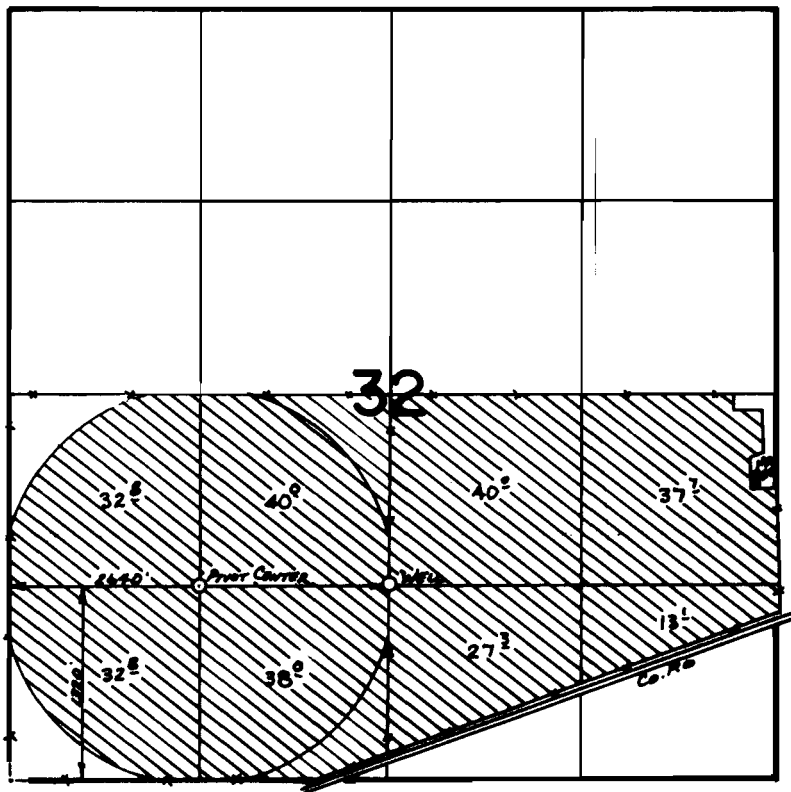

FINAL PROOF SURVEY UNDER

Application No. G-8771.. Permit No. G-8199.....
IN NAME OF

.....JOE OXFORD, JR.....

Surveyed Oct. 13... 1983., by L.M. TOLL.....