


G10044  
52785

T.28S.,R.16E.,W.M.

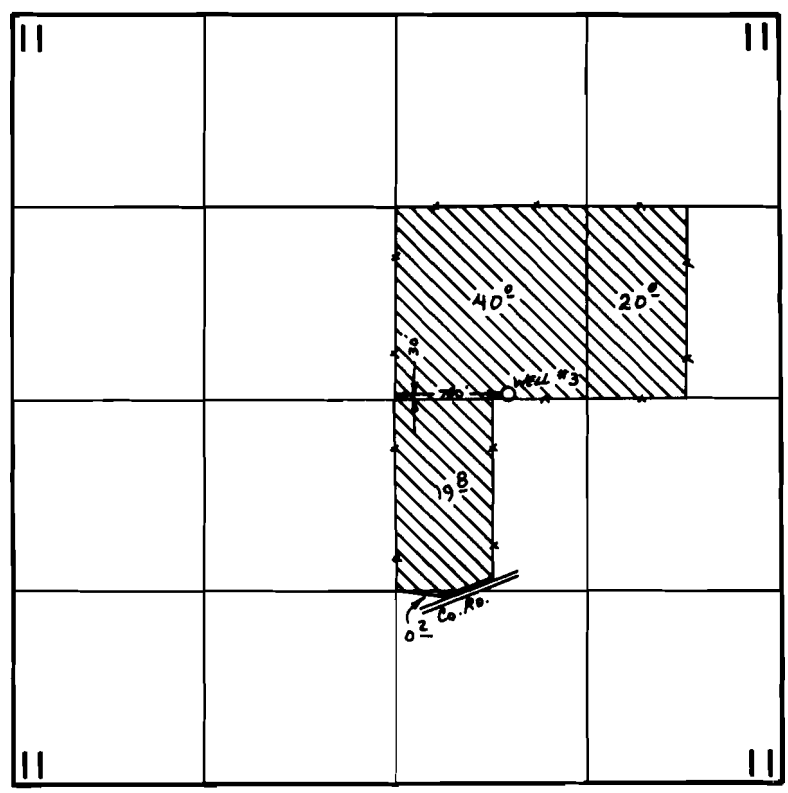

**FINAL PROOF SURVEY**  
UNDER

Application No. G-10901. Permit No. G-10044.....  
IN NAME OF

.....RENATE WOLFSTRUM.....

Surveyed Oct...12... 1983., by L. M. TOLL.....