


T-4818

T.27S. R.19E., W.M.

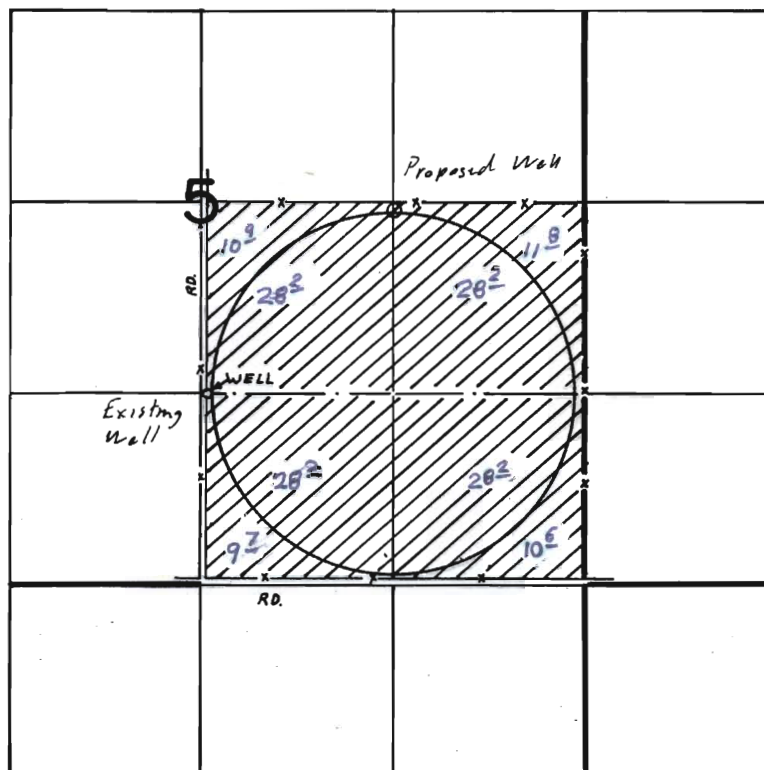

WELL LOC. 1320' N. & 2600' W. FROM S.E. COR. SEC. 5

FINAL PROOF SURVEY
UNDER

Application No. G-7121..... Permit No. G-6693...
IN NAME OF

HARLAN F. & ELOISE OSTER.....

Surveyed JUL 19, 1977, by D.M. NORBY.....