


T.18S. R.28&3W. W.M.

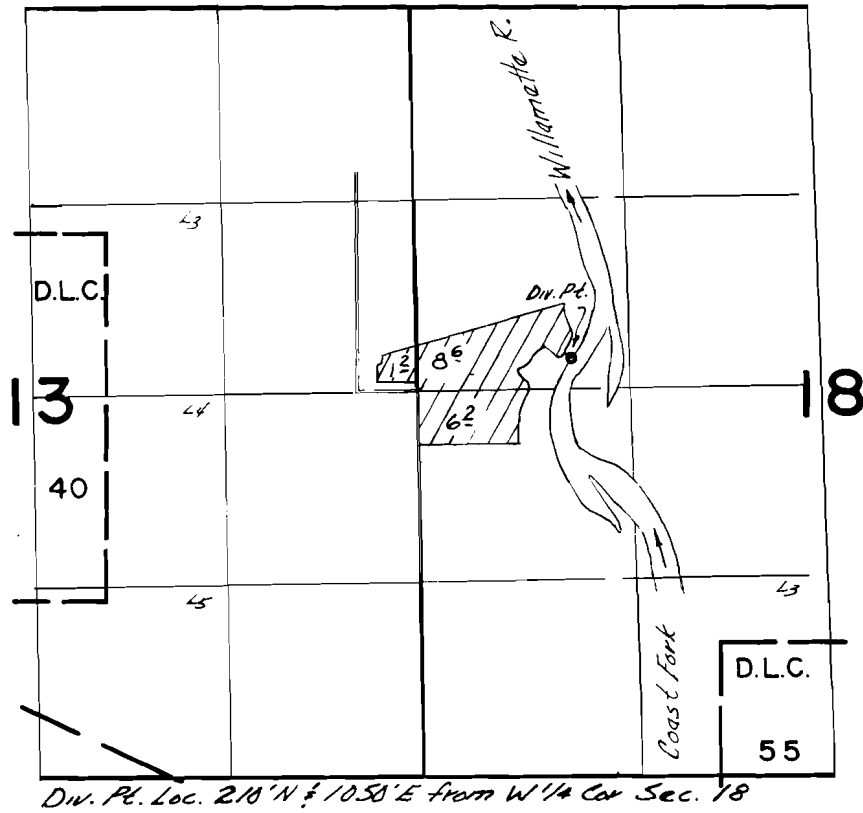

FINAL PROOF SURVEY UNDER

Application No. 58388.. Permit No. 44000....
IN NAME OF

.....Steven M. Houston.....

Surveyed Oct....9.... 1979., by C.R.RODRIGUEZ.