


T.24S.,R.37E.,W.M.

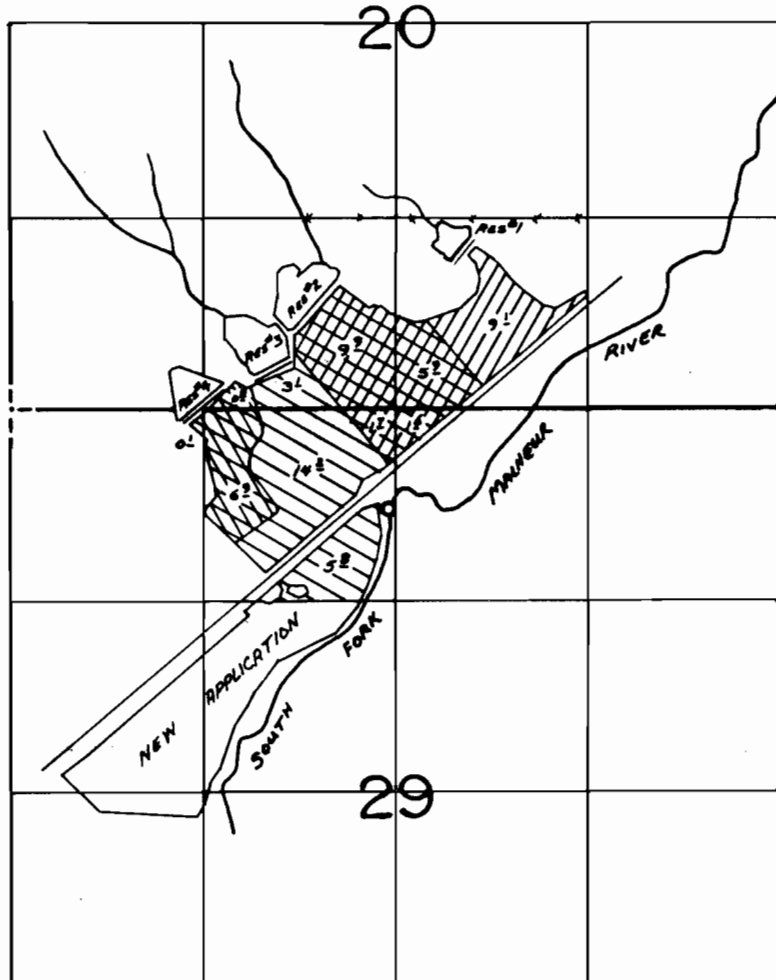

RESERVOIR LOCATIONS: #1- 1100 FT. N AND 3100 FT. E

#2- 700 FT. N AND 2080 FT. E

#3- 280 FT. N AND 1800 FT. E

RIVER DIVERSION: 680 FT. S AND 2580 FT. E

ALL FROM THE SW CORNER SECTION 20

FINAL PROOF SURVEY

UNDER

R-45740

45741

51778

R-5403

34061

40680

Application No. R-51941 Permit No. R-6483...

IN NAME OF

.....WAYNE J. BLAYLOCK.....

Surveyed Oct. 3, 1981, by L. TOLL.....

