


T.17S.,R.47E.,W.M.

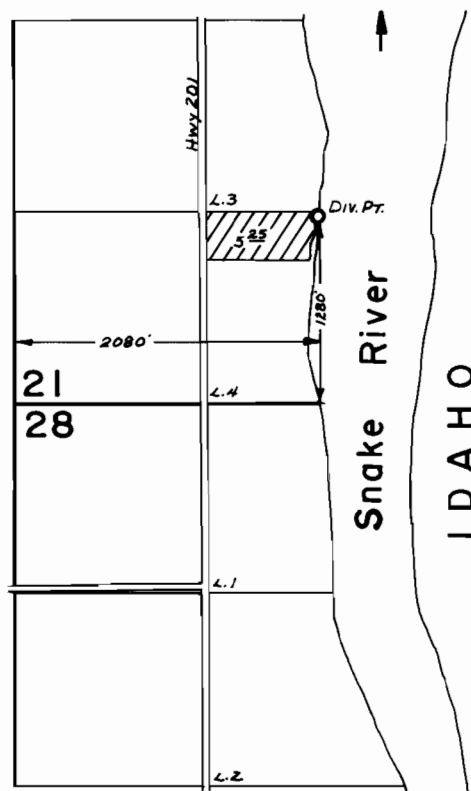

FINAL PROOF SURVEY
UNDER

Application No. 61413... Permit No. 45689.....
IN NAME OF

JOHNNY SCHAEFER

Surveyed Aug. 31, 1981, by B. BISHOP.....