


5-2-83

# T. 4S., R. 1W., W.M.

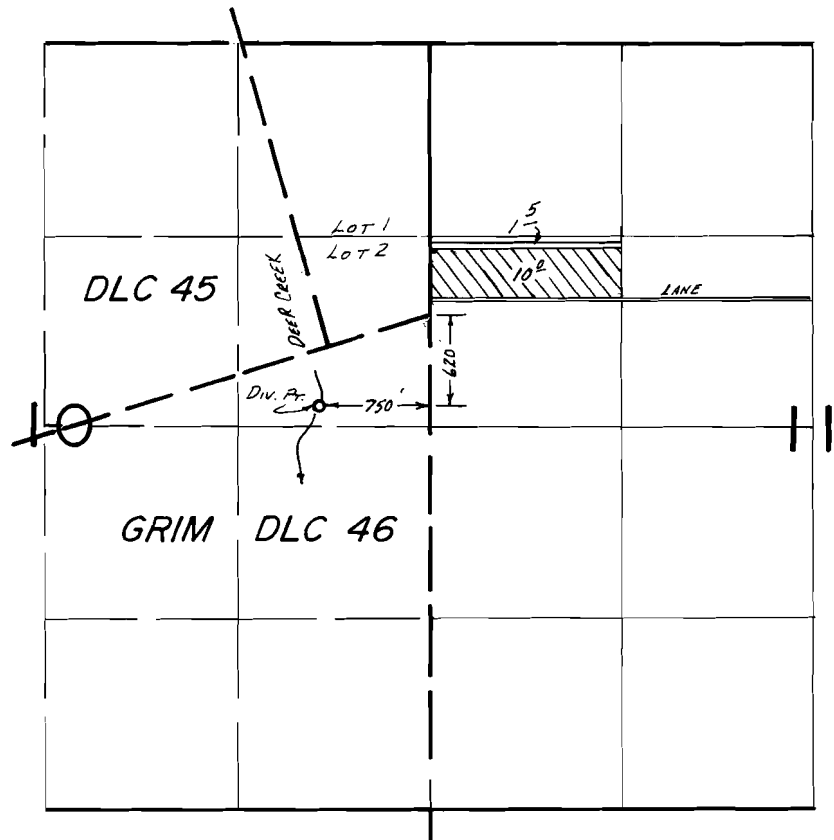

## FINAL PROOF SURVEY UNDER

Application No. 59884.. Permit No. 45192.....  
IN NAME OF

.....RAYMOND MICHAEL IVERSON.....

Surveyed Sept. 8..... 1983., by L. M. TOLL.....