


G6333
52814

T. 2 S. R. 26 E. W. M.

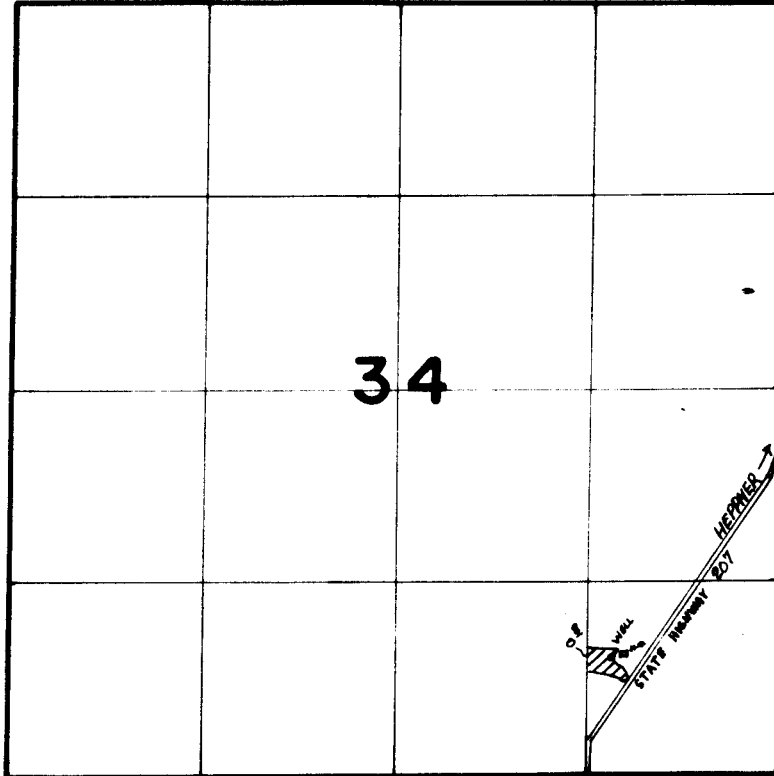

1" = 1320'



WELL LOCATED 810' N. AND 1150' W. FROM THE S.E. SEC. COR. SEC. 34

FINAL PROOF SURVEY UNDER

Application No. G-6846 Permit No. G-6333.....
IN NAME OF

.....RON & JO BORST.....

Surveyed ...6-26..... 1964., by V.L. CHURCH.....