


68232
52815
52816

T. IS. R. 25E. W.M.

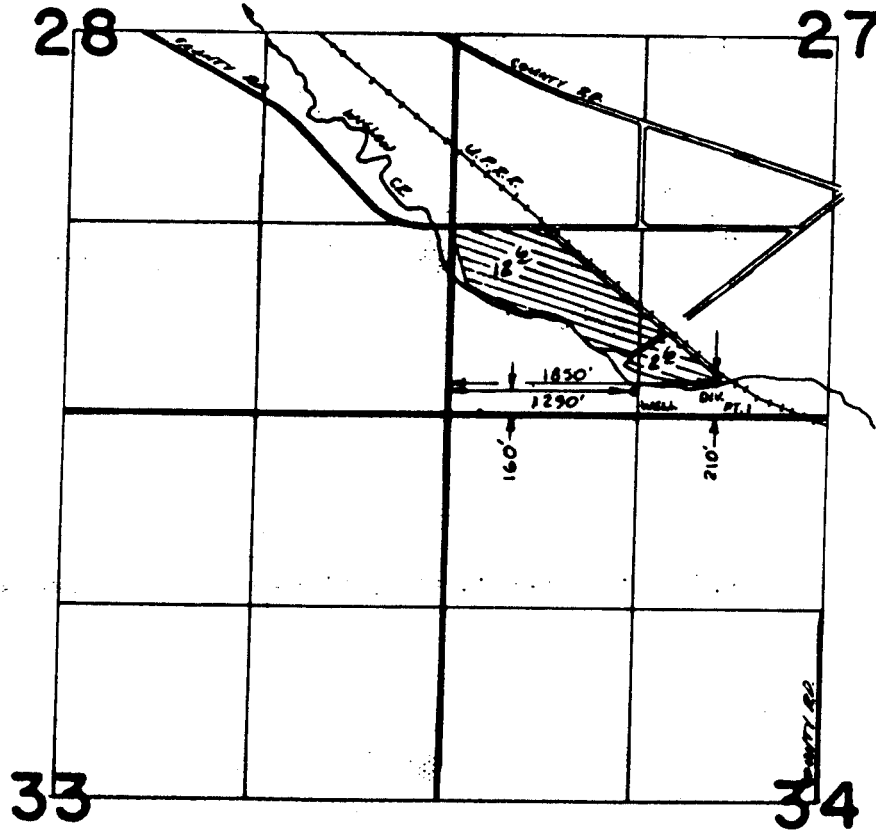

FINAL PROOF SURVEY UNDER

G-8702 G-8232
Application No. 45724. Permit No. 34120..
IN NAME OF

.....MARVIN.....D.....WAY.....

Surveyed ..8:20..... 1979., by ..H. Chasch.....