


# T.I.S.R.3E.W.M.

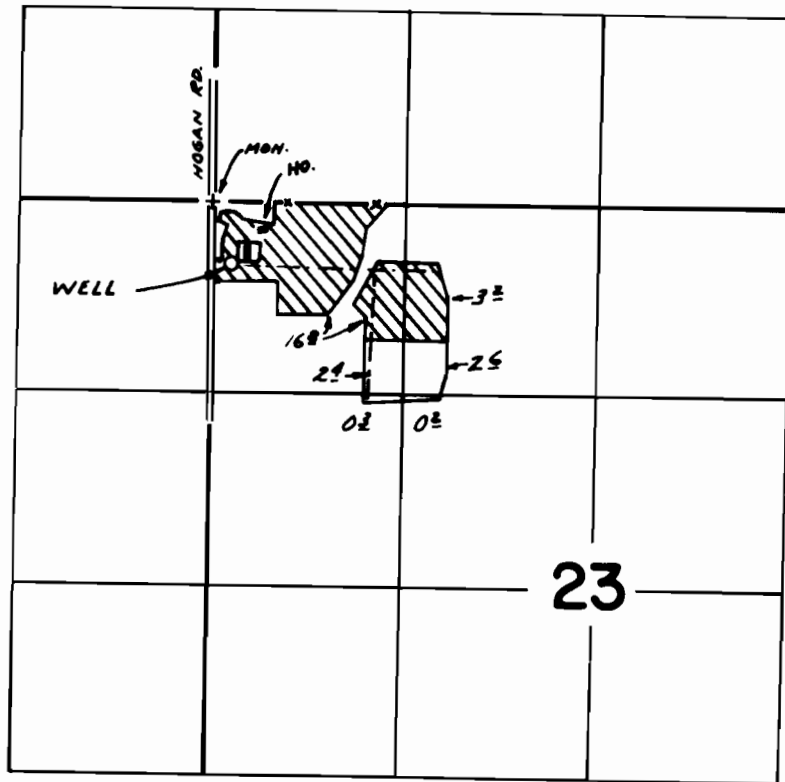

WELL LOC: 420' S. & 140' E. FROM N.W. COR. SEC. 23

## FINAL PROOF SURVEY UNDER

Application No. G.:5875 Permit No. G.:5606  
IN NAME OF

.....GLEN T. SCHAEFFER.....

Surveyed JAN. 7, 1980, by R.G. MURKEN