


T.3N.R.1W.W.M.

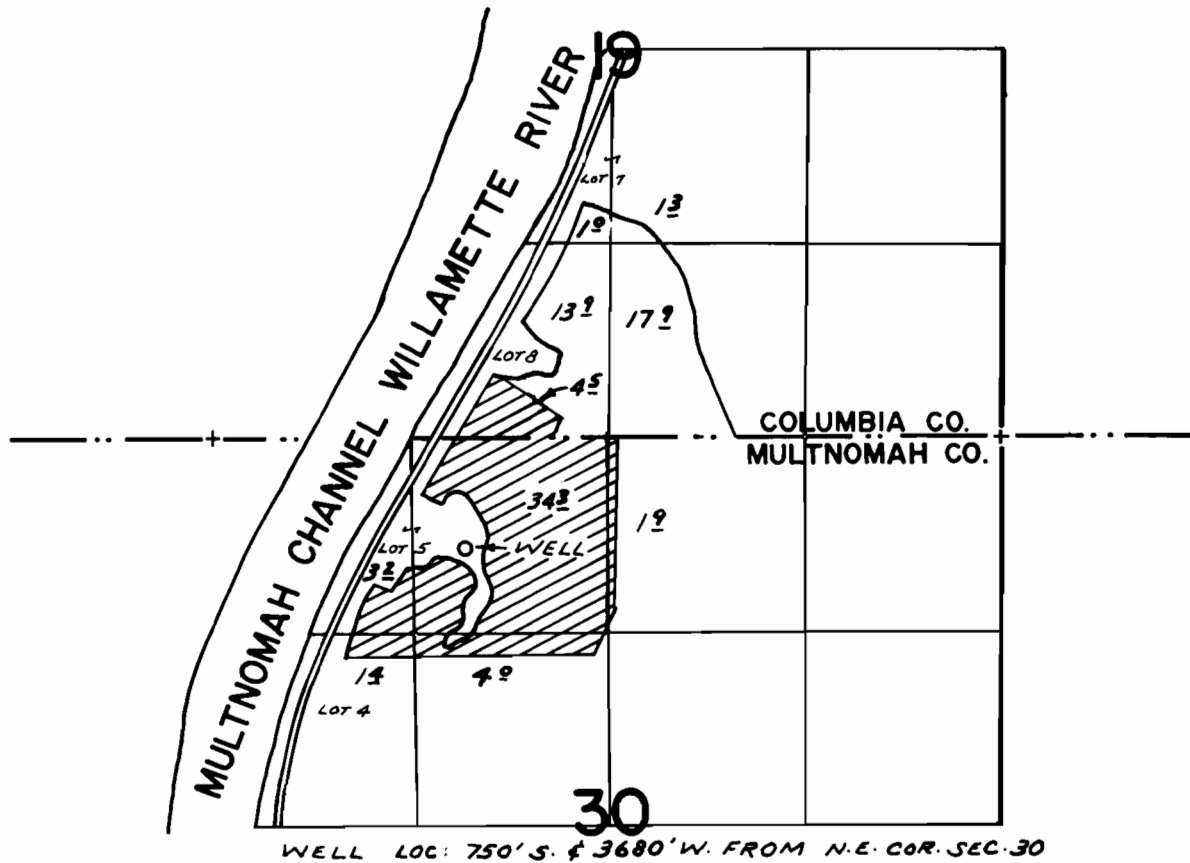

FINAL PROOF SURVEY

UNDER

Application No. G-6992. Permit No. G-6497.
IN NAME OF

FRED J. CHOLICK

Surveyed SEPT. 7, 1979, by R. G. MUCKEN