


T.3N., R.30E., W.M.

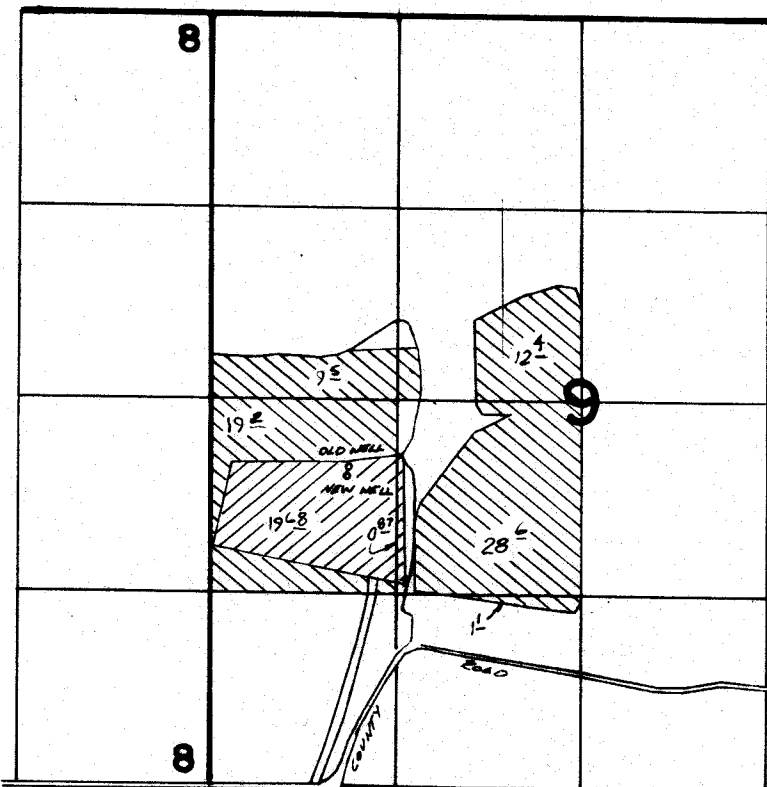

NEW WELL LOCATION 520'S. & 940'E. FROM W 1/4 COR. SEC 9
 OLD WELL LOCATION 450'S. & 960'E. FROM W 1/4 COR. SEC 9



PRIMARY



SUPPLEMENTAL

FINAL PROOF SURVEY UNDER

Application No. **G:6359** Permit No. **G:5957**
 IN NAME OF

.....**LEON A. REESE**.....

Surveyed 9-26..... 1978., by **P. BARWIN**.....