G 8209

54740
53258

# T. 4N., R. 29E., W.M.

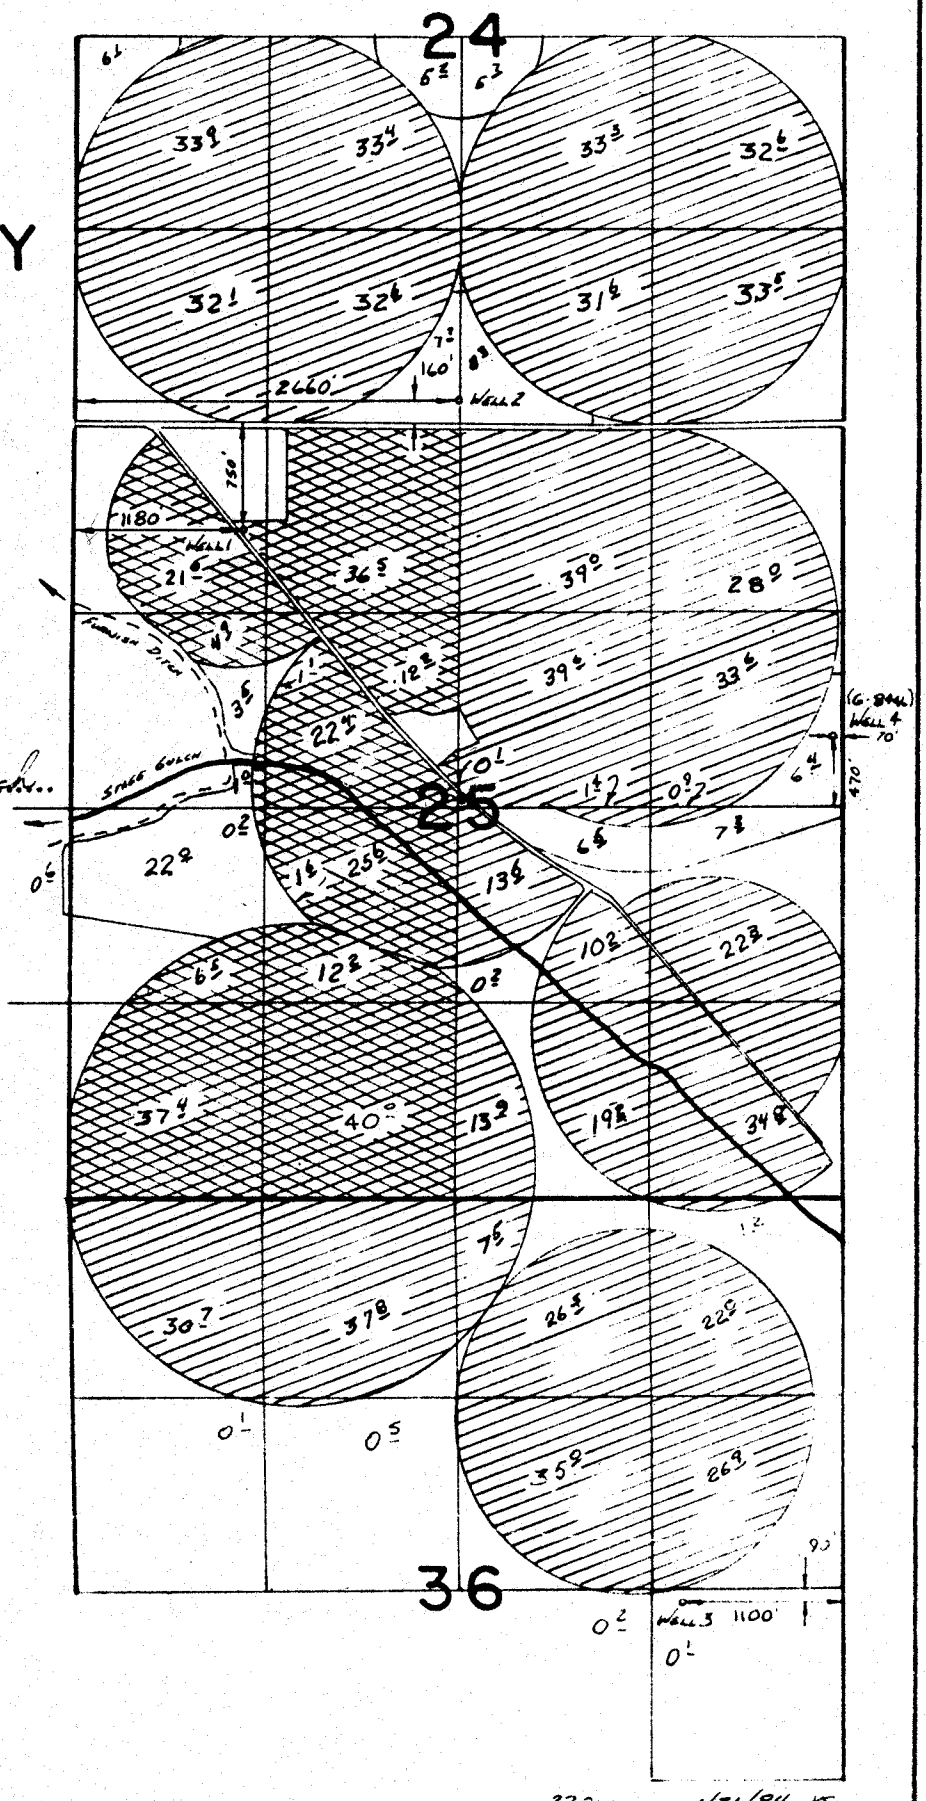


## FINAL PROOF SURVEY

UNDER

APPL. G·8665 PER. G·8209
G·9062 G·8446

IN NAME OF

JACK ZABRANSKY & SON

SURVEYED FEB. 17, 1983, BY V. L. Church

PRIMARY G-8209
SUPPLEMENTAL G-8446

SUPPLEMENTAL G-8446, G-8209

220L 11/31/84 JS