


G 9162
52926

T. 6N., R. 35E., W.M.

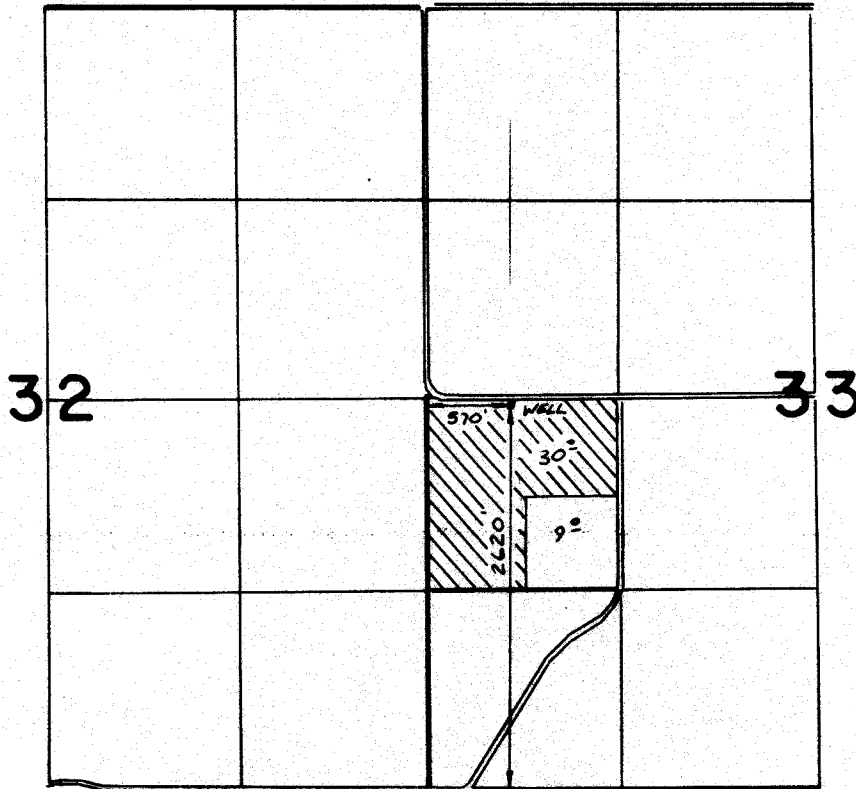

FINAL PROOF SURVEY
UNDER

Application No. **G:10057** Permit No. **G:9162**
IN NAME OF

JOHN E. KELLY

Surveyed *March 31, 1982*, by *Yvonne Ann Church*