


T. 5N., R. 29E., W.M.

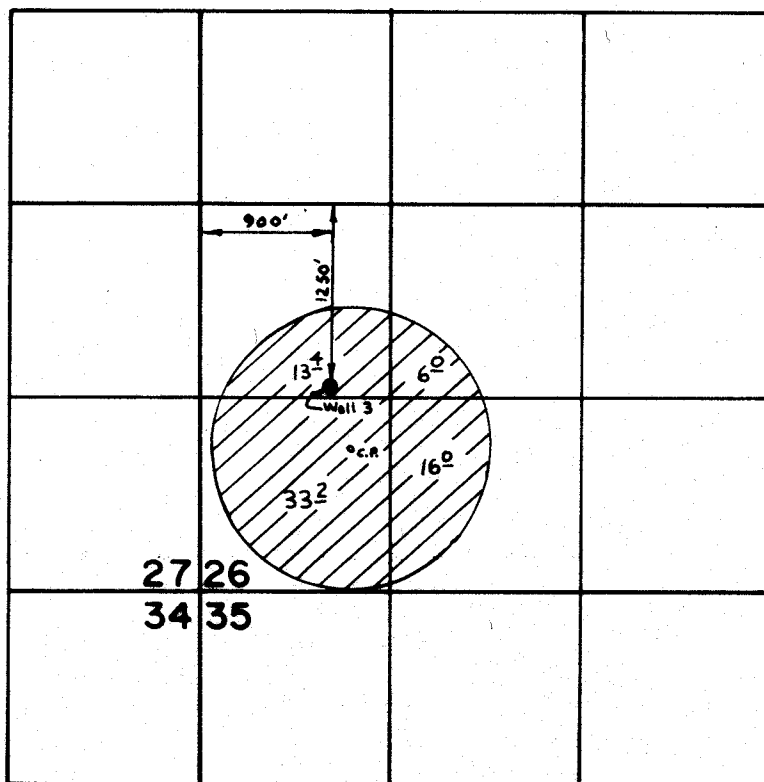

SCALE: 1" = 1320'

FINAL PROOF SURVEY UNDER

Application No. G-6910 Permit No. G-5699
IN NAME OF

L. J. & ALICE MARKS

Surveyed APR. 3 1978, by R. BARWIN