T. 5N. R. 29E. W.M.

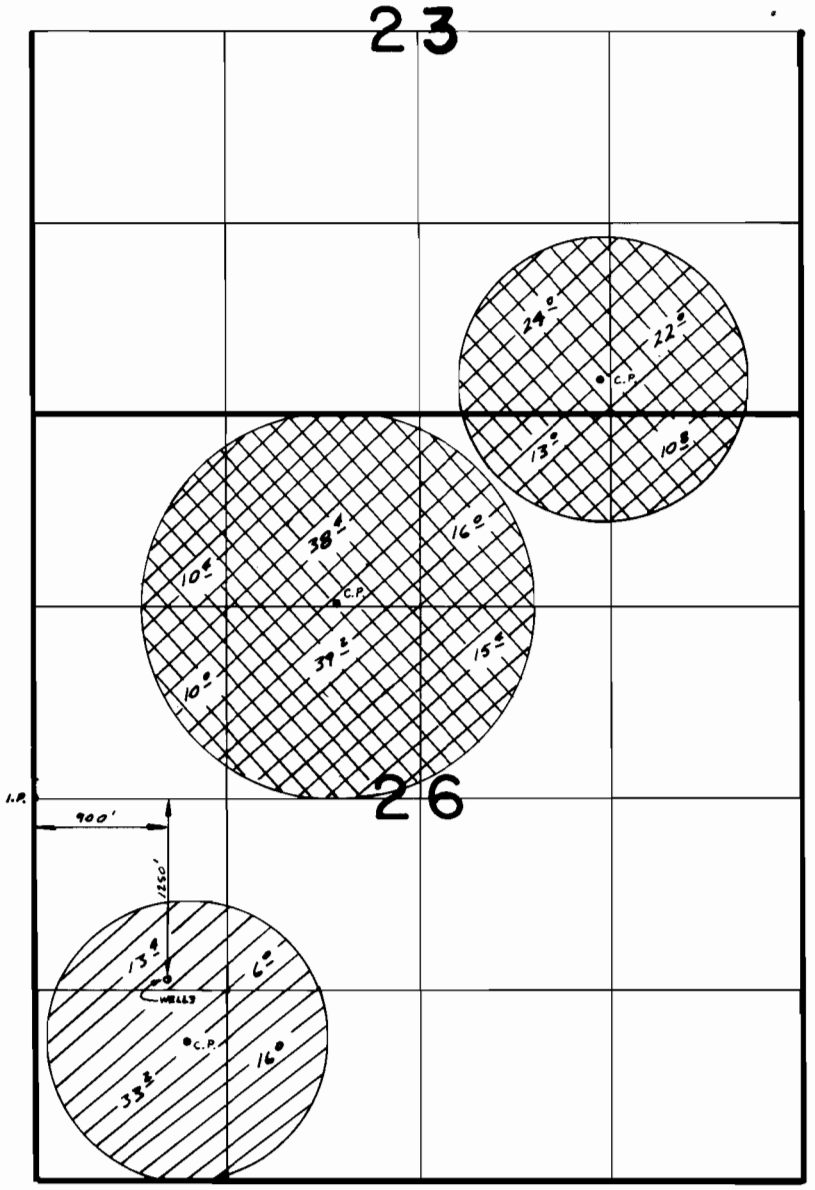

Superceded
9-26-84
GEC

FINAL PROOF SURVEY
UNDER

Application No. 60172 G-6910 Permit No. 45108 G-5699

IN NAME OF

L. J. & ALICE MARKS

Surveyed 4-3 1978, by R. BARWIN

FL 7-21 FL 7-23
PTS-1978-P-A

V.L.C.