


T.5N.R.28E.W.M.

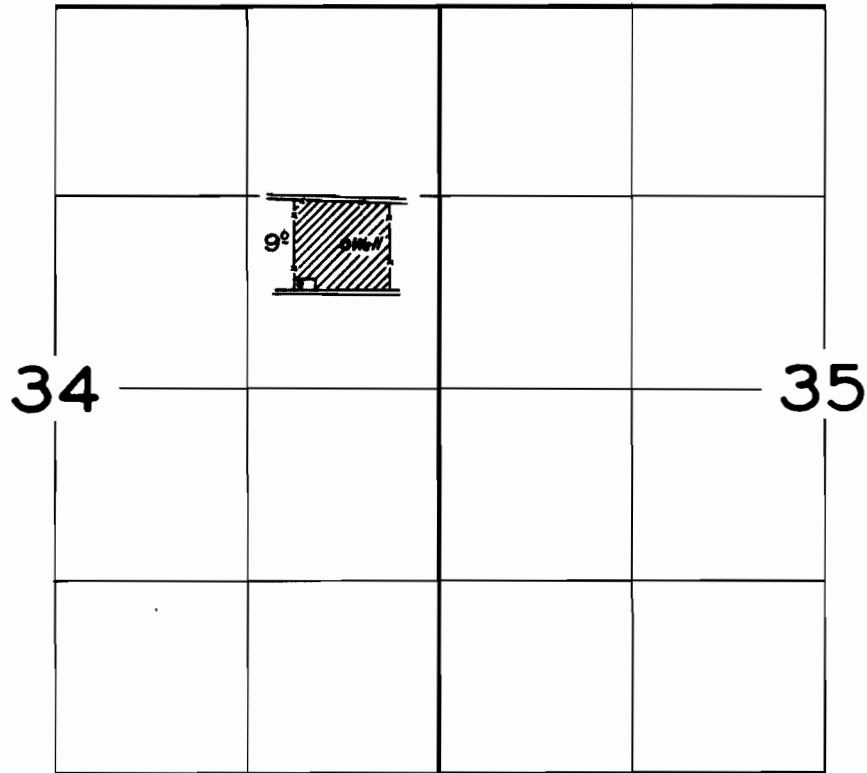

FINAL PROOF SURVEY
UNDER

Application No. **G-1438**... Permit No. **G-1314**.....
IN NAME OF

S. W. & FLORENCE STEWART.

Surveyed June 12 1962, by *A. Jackson*