


T. 4N. R. 29E. W.M.

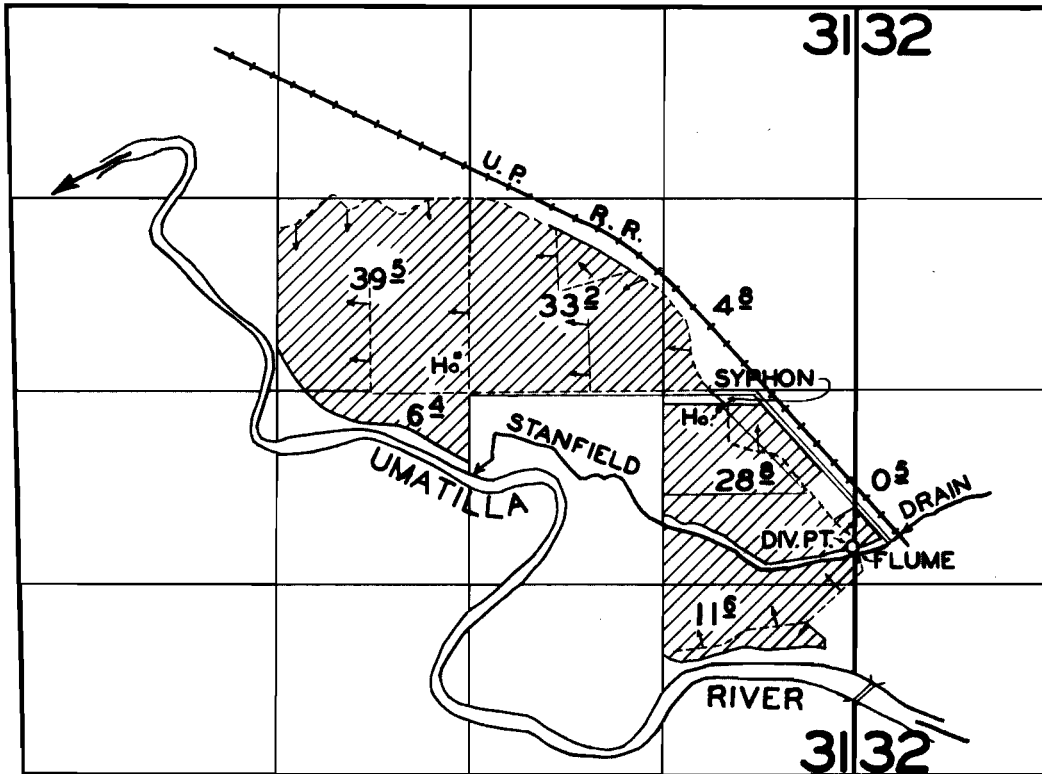

**FINAL PROOF SURVEY**  
UNDER

Application No. 22914 Permit No. 18122  
IN NAME OF

**J.J. OBERSON & L.M. GOSSLER**

Surveyed MAY 16 1957, by *C.O. Butcher*