


T. 3S., R. 38E., W.M.

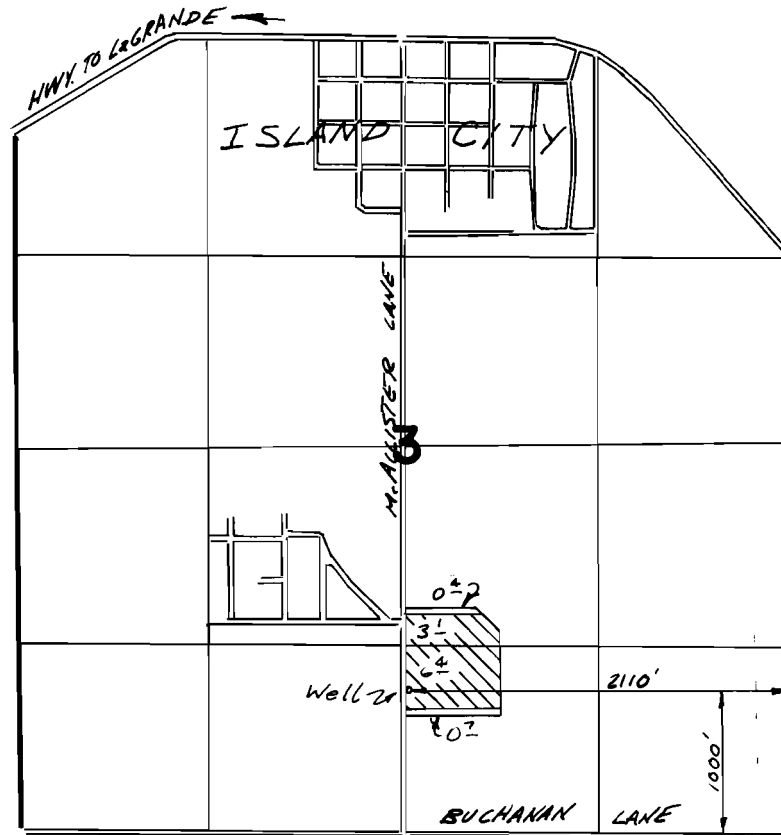

FINAL PROOF SURVEY
UNDER

Application No. G-9750 Permit No. G-9055
IN NAME OF

ISLAND CITY CEMETERY

Surveyed 11-17 1981, by V.L. Church