


69508

T. 6N., R. 35E., W.M.

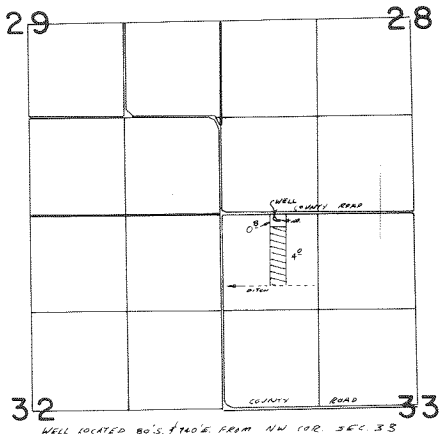

FINAL PROOF SURVEY
UNDER

Application No. **G-9900** Permit No. **G-9508**
IN NAME OF

..... **EDDIE PHILLIPS**

Surveyed *March 21, 1981*, by *Samson Lee Church*
July 6 82

REV. 6/24/76
DPS-1082-1-1