


T.3S. R.46E. W.M.

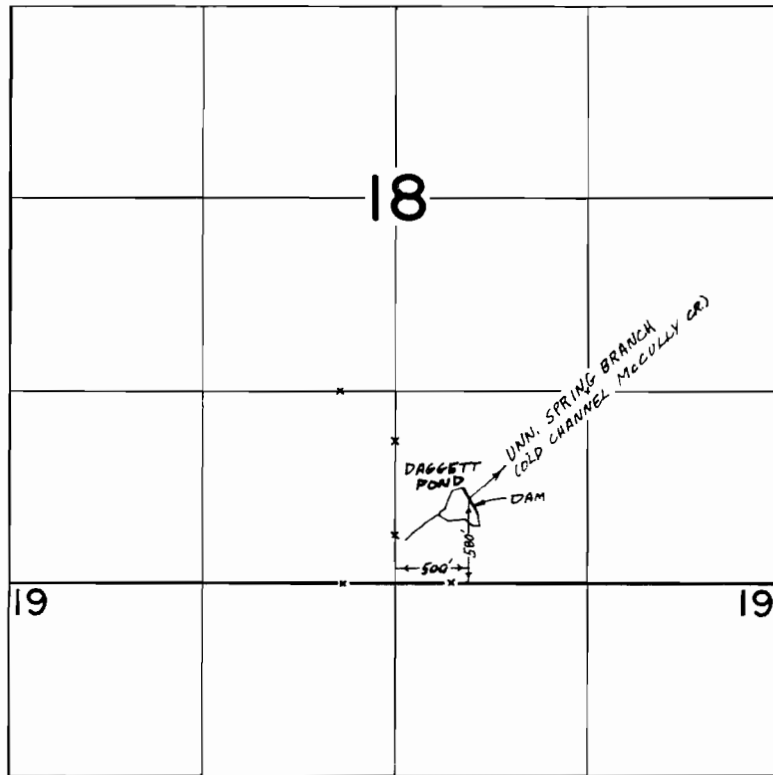

FINAL PROOF SURVEY
UNDER

R-48837 R-5835
Application No. 48838 Permit No. 36071
IN NAME OF

ROY W. DAGGETT & EMILY DAGGETT

Surveyed NOV. 6 1975, by L. H. NUNN